


Map of

Walker-Chinnock-Mashburn
Leased property
in Siskiyou U.S. Forest Reserve
Showing pipe line from spring branch

Section 25 Twp 34SR8W

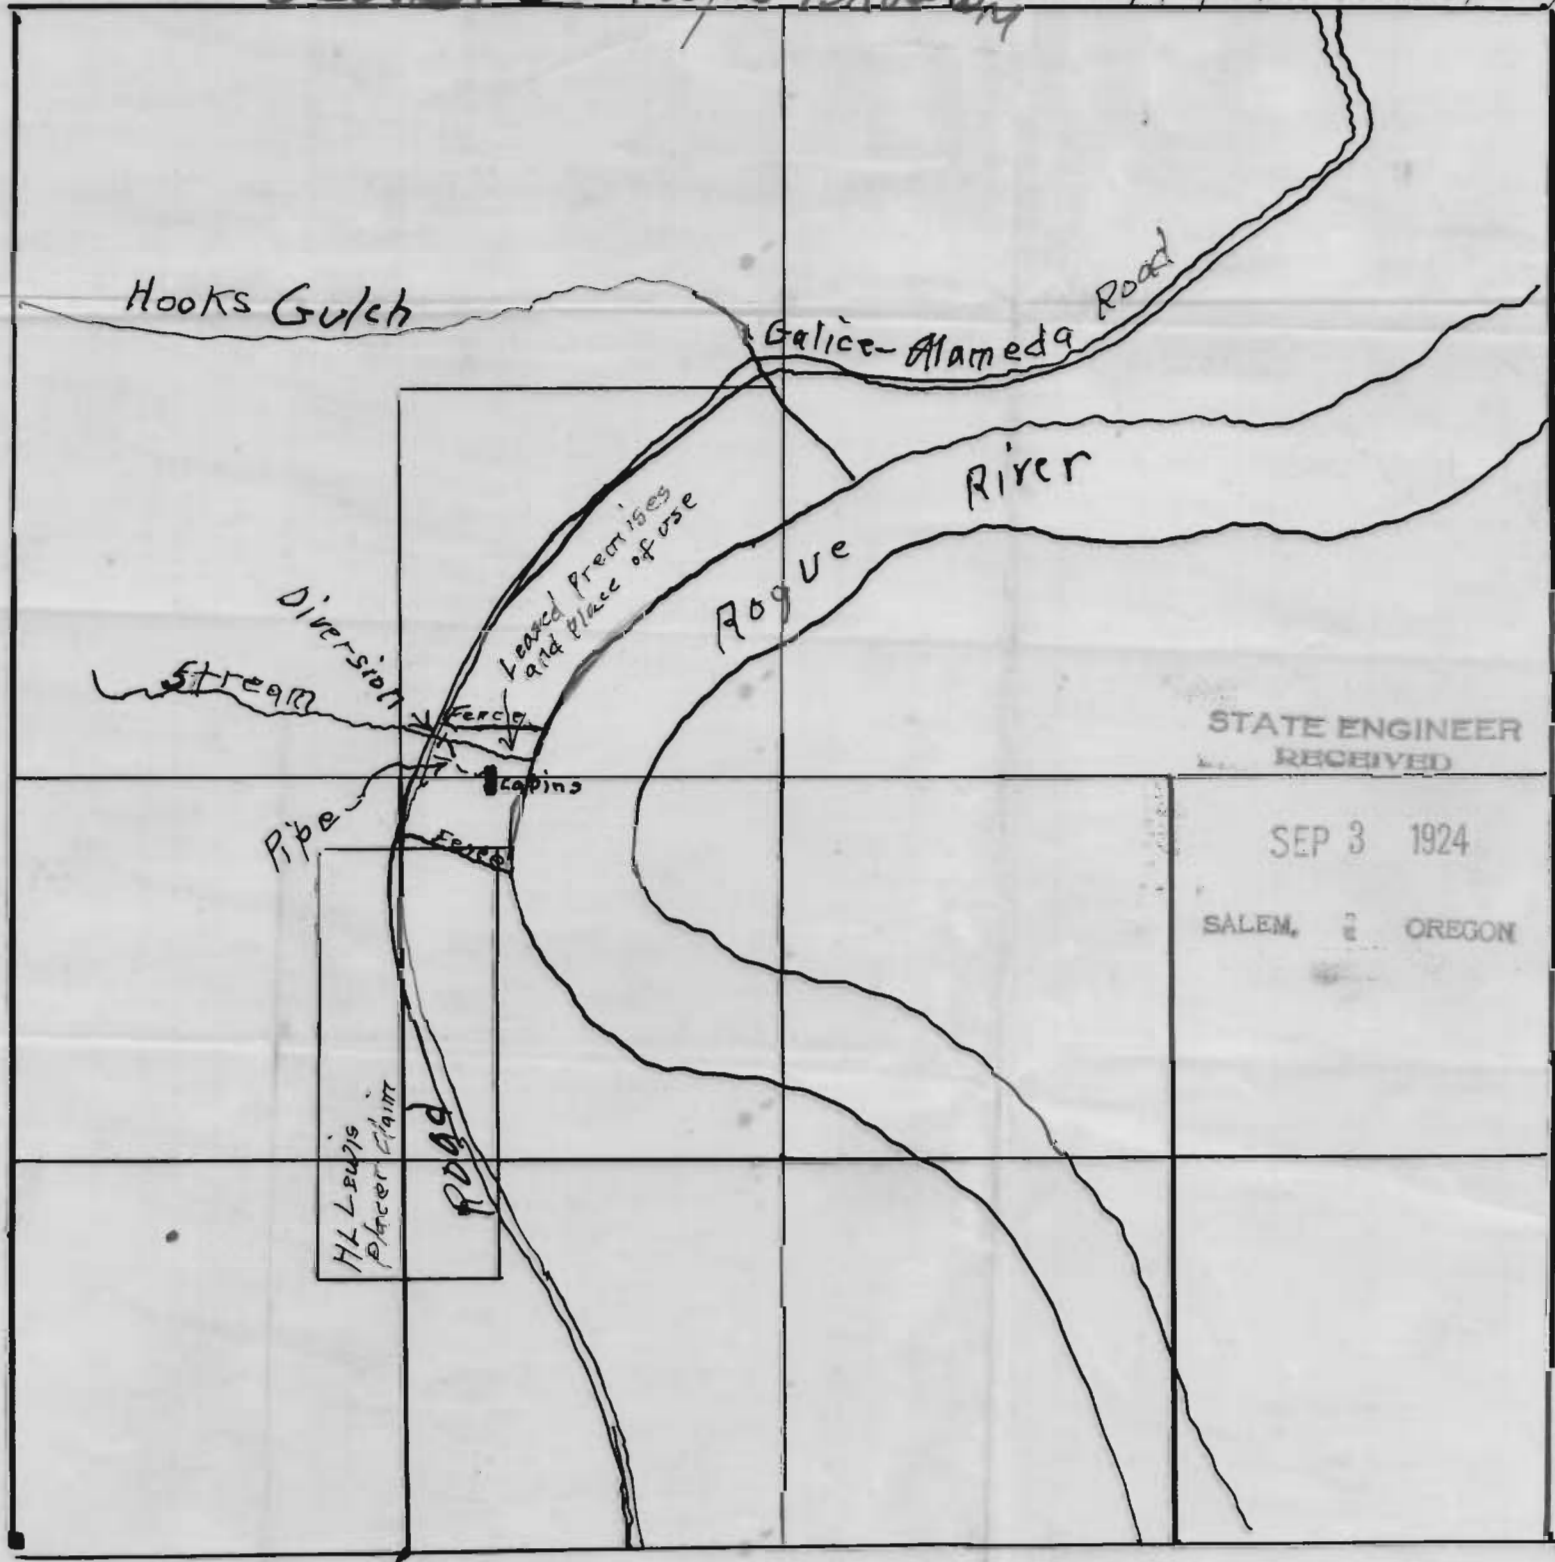

Application No. 9798
Permit No. 6490