


477

Sec. 29  
30  
31  
32  
Tp. 2 S.  
R. 38 E.

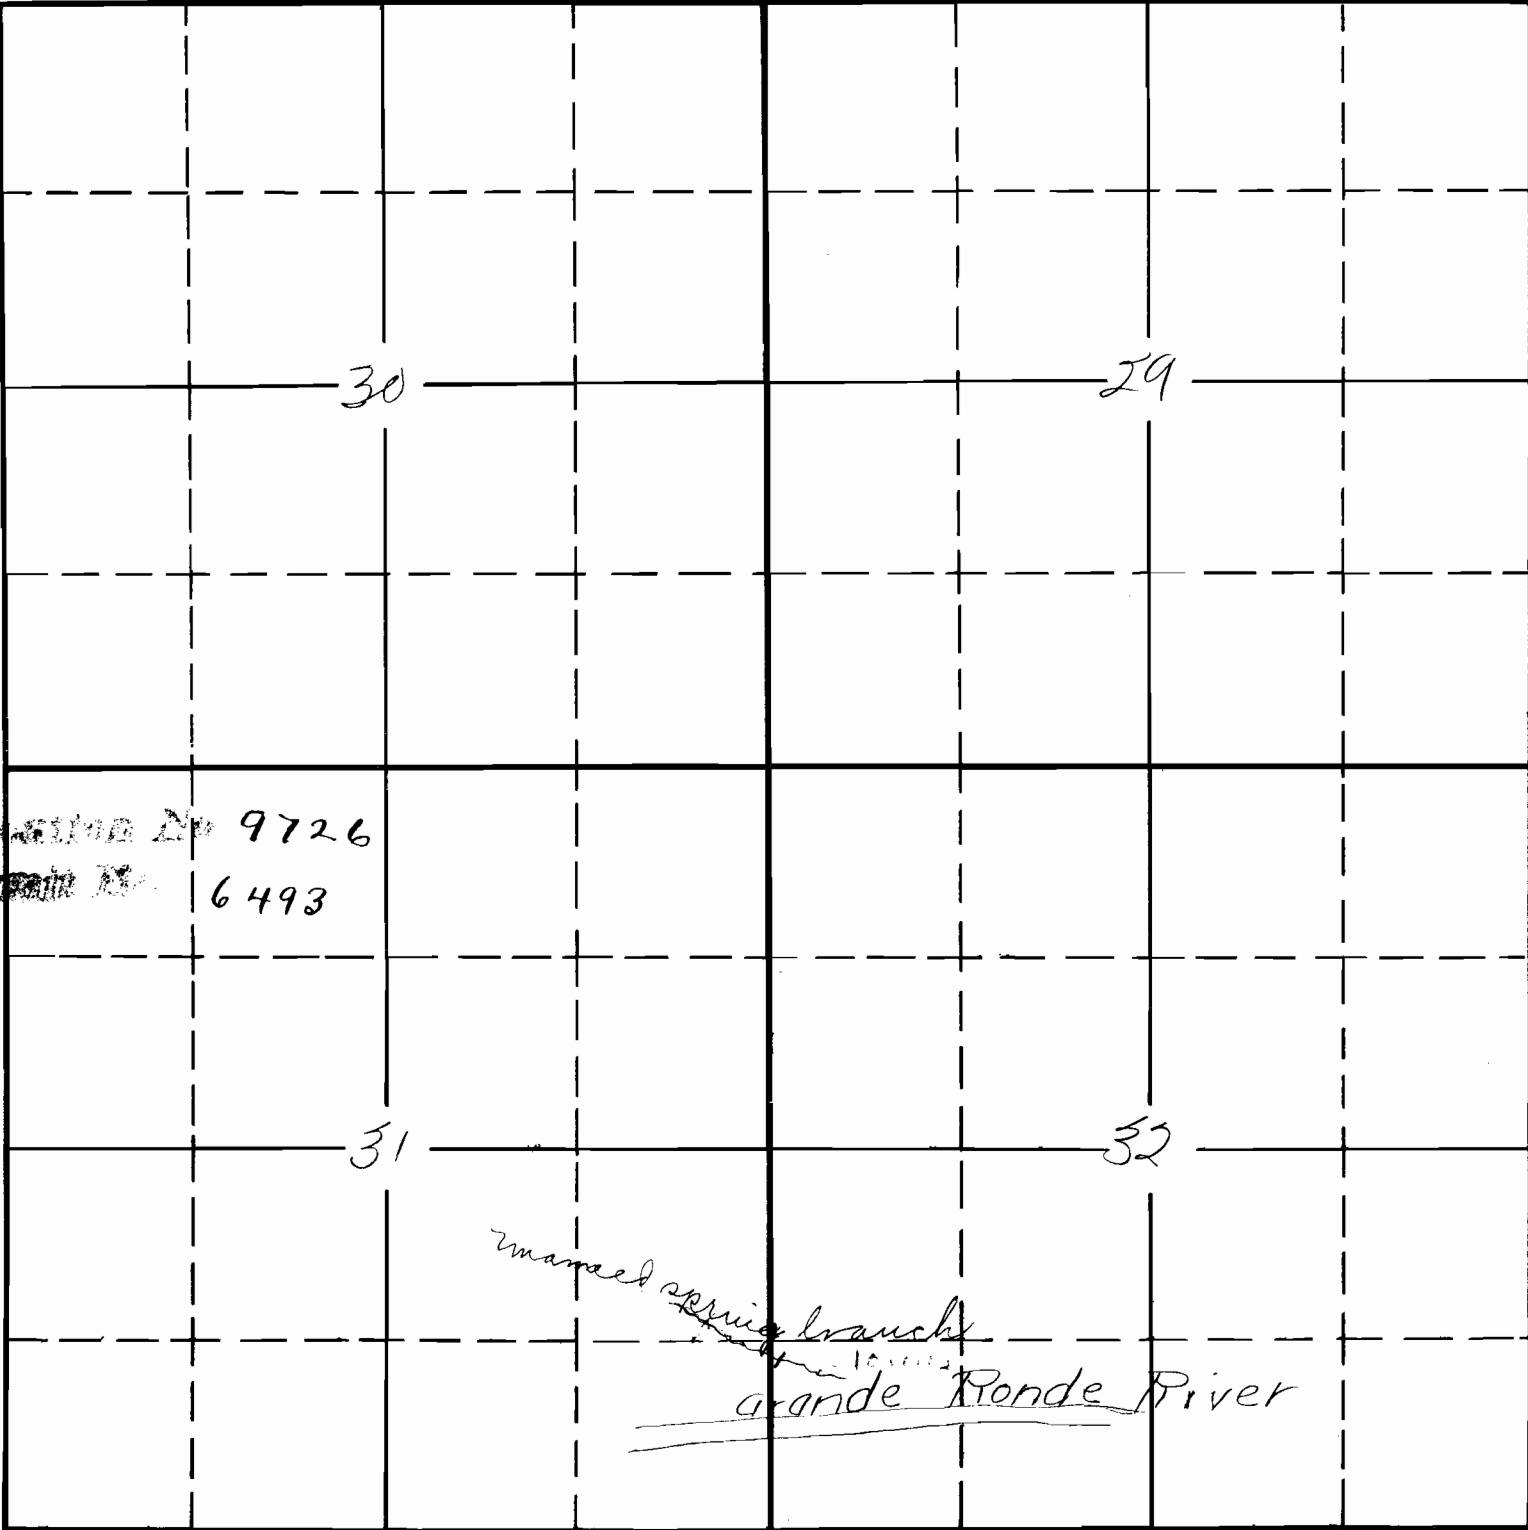

Application No 9726  
Permit No. 6493

Manuel spring branch  
Grande Ronde River