

app 9758


Application No. 9758
Permit No. 6496

N

T. 1 N. R. 4 W. W.M.

W

E

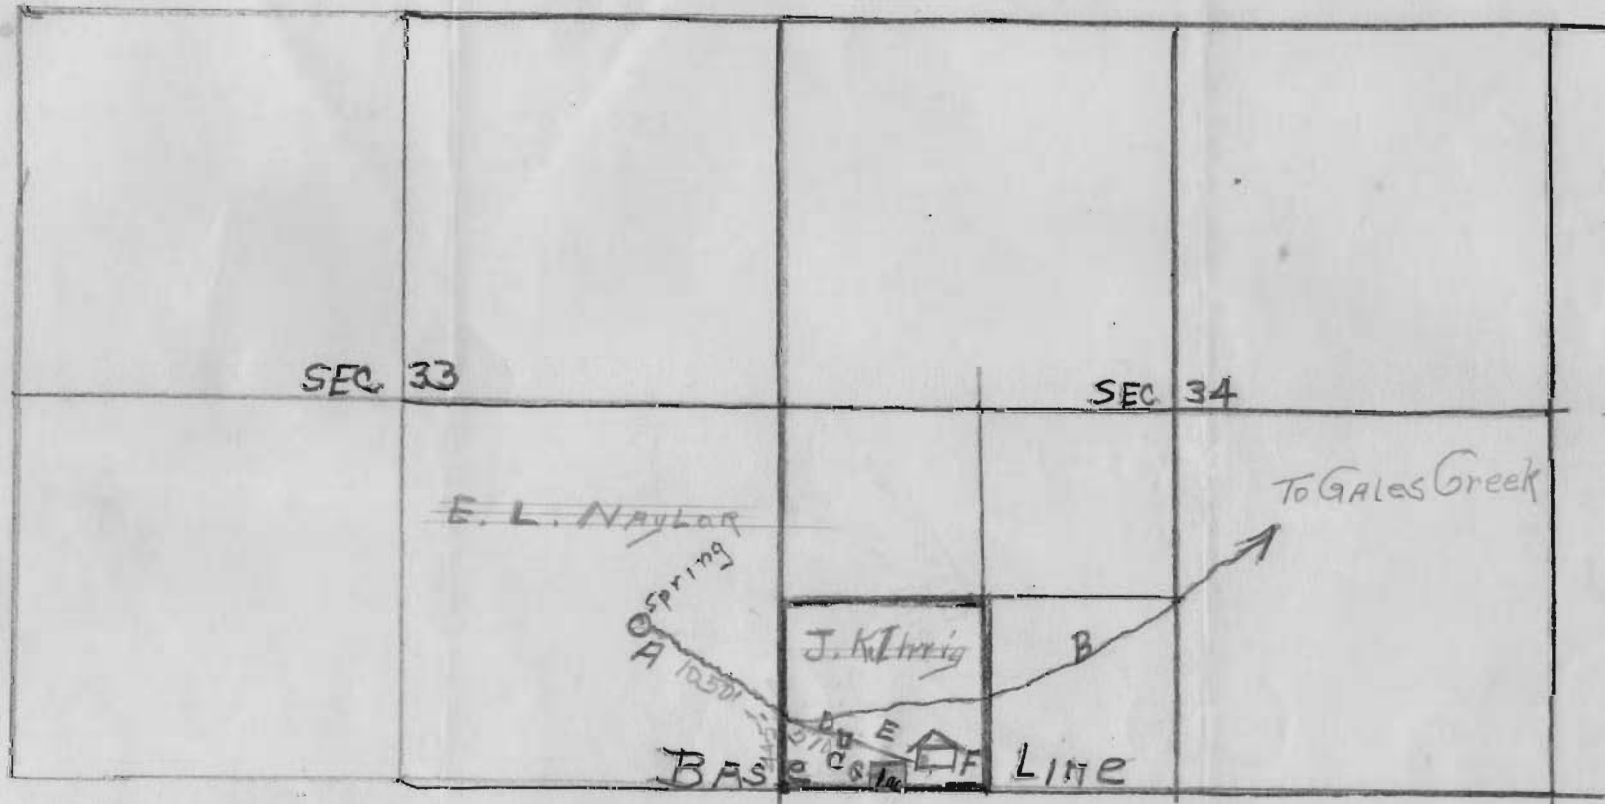

- AB - Spring Branch
 - C - Reservoir
 - D - Ditch - 510 ft From intake To Reservoir
 - E - Pipeline
 - F - Dwelling
 - G - 1/2 Acre Garden irrigated
- Note - Water is discharged from Pipe Line to Kitchen Sink