


Sketch showing
Location of Spring Site For

Water System
Banks, Ore.

June, 1924

Joe H. Pos
Engineer

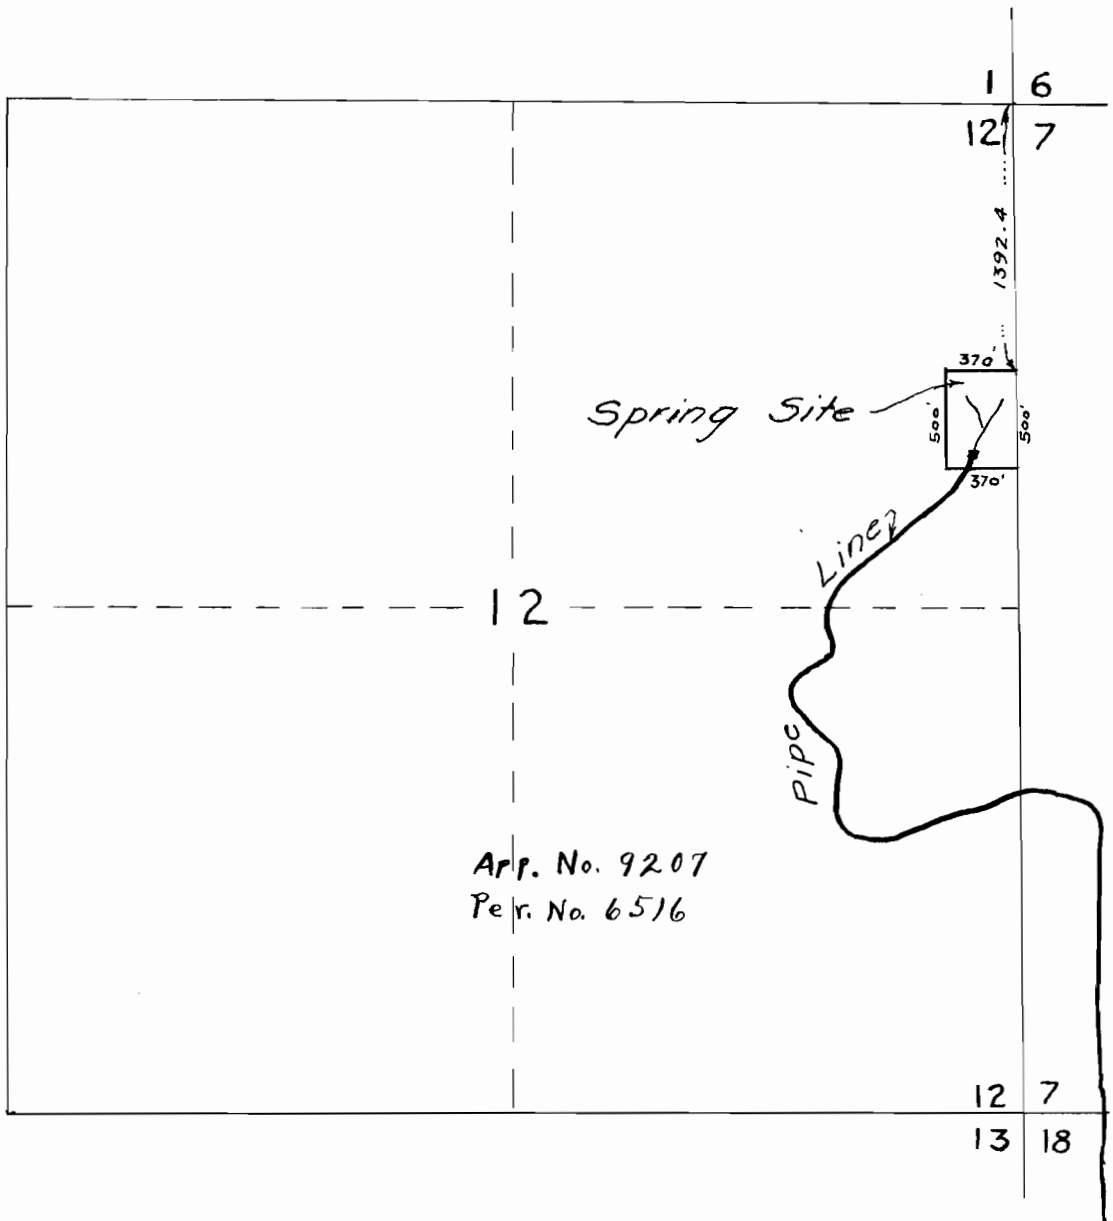


App. No. 9207

Per. No. 6516

Township 2 North,

Range 3 West.

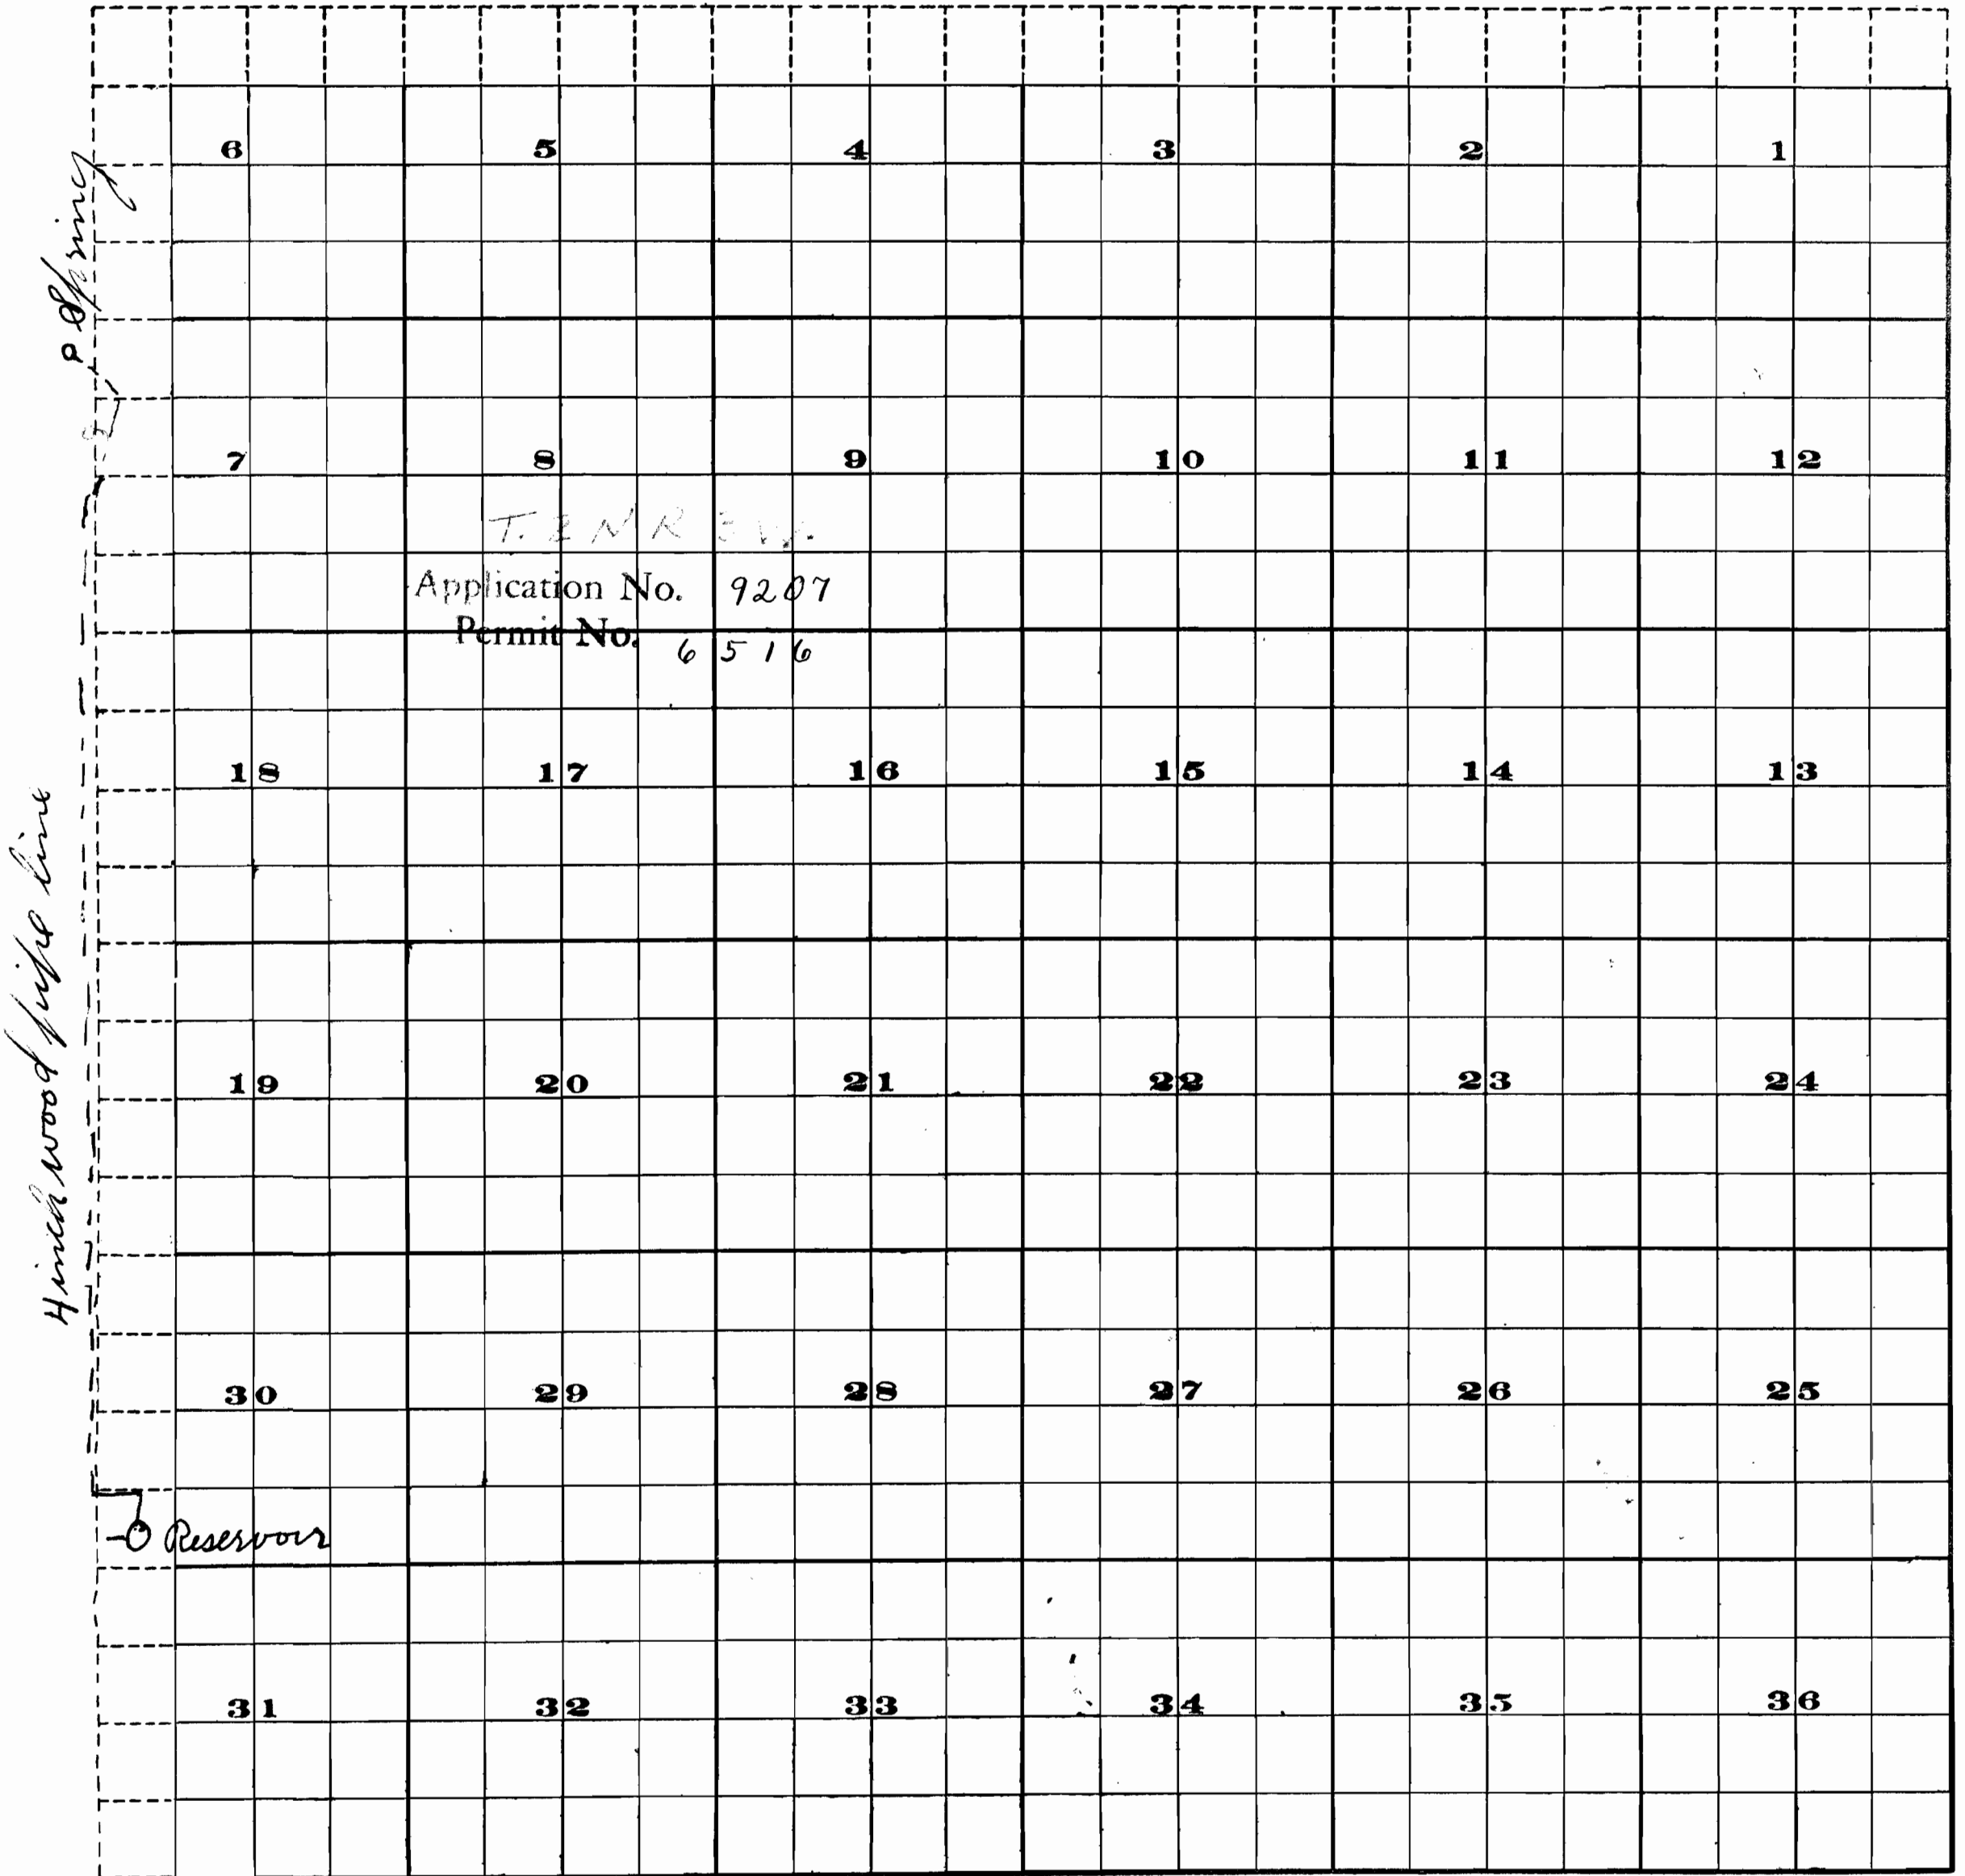

Scale of Feet.