


7861

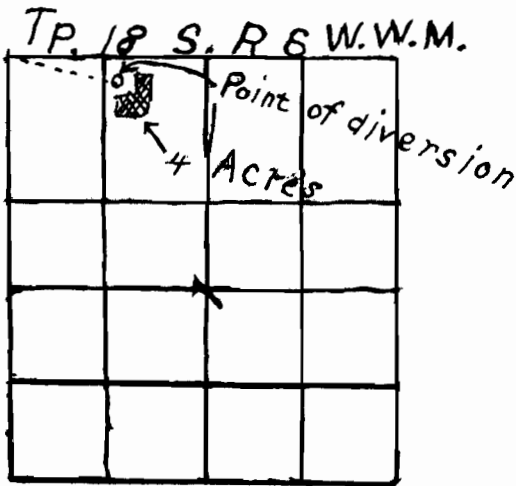

Section 1.

STATE ENGINEER
RECEIVED

SEP 24 1924

SALEM. OREGON

Application No. 10000

Tract No. 6526