


Township 21 S


Range 3 W.

5/10/24

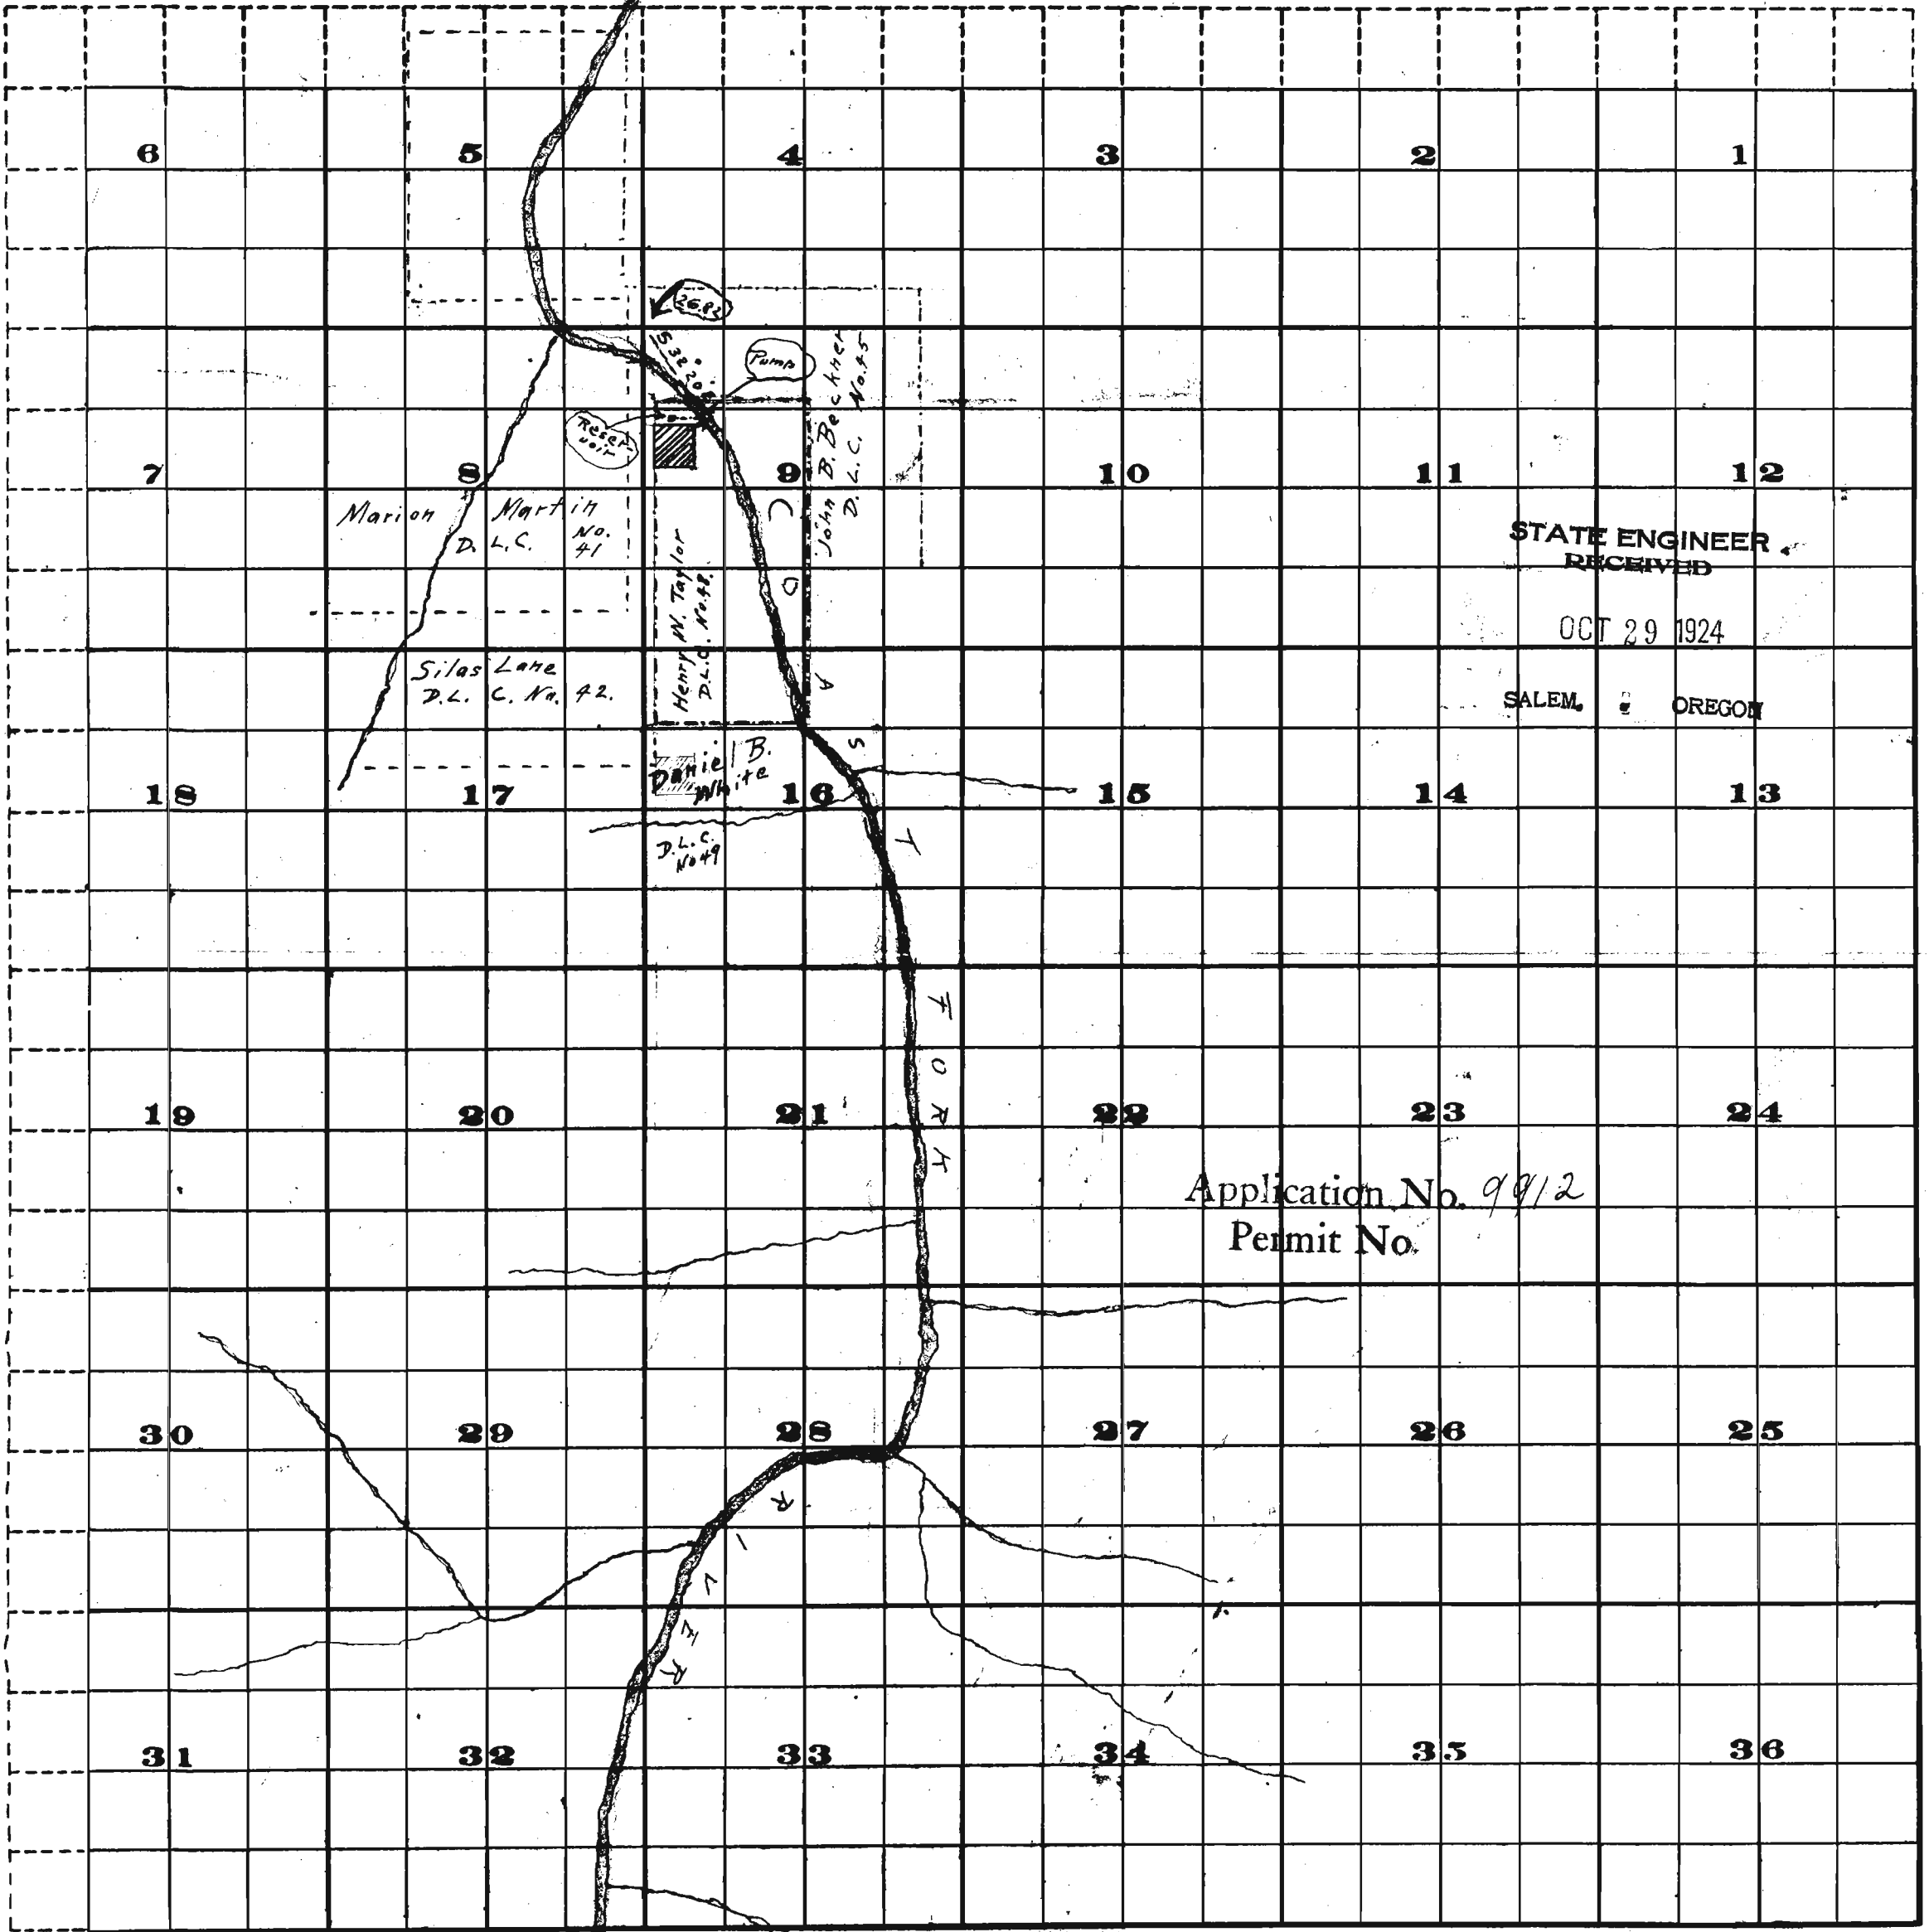

STATE ENGINEER  
RECEIVED  
OCT 29 1924  
SALEM, OREGON

Application No. 9912  
Permit No.

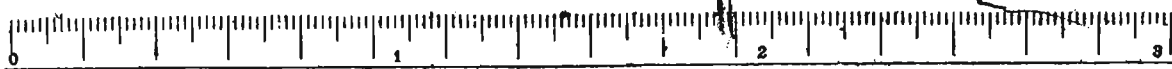

Scale of Feet.

4615