


A. 9866  
P 6551

Twp. 36 S 5 W

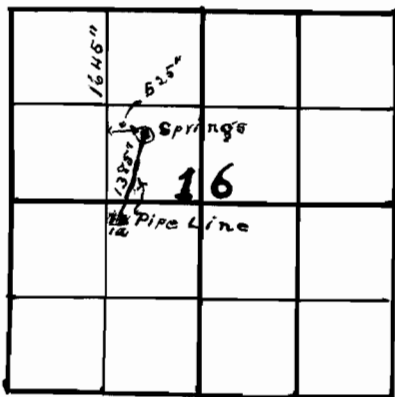


don . . . . .