


HP 89

Township

1. S.

Range

4 W. Will. Mer.

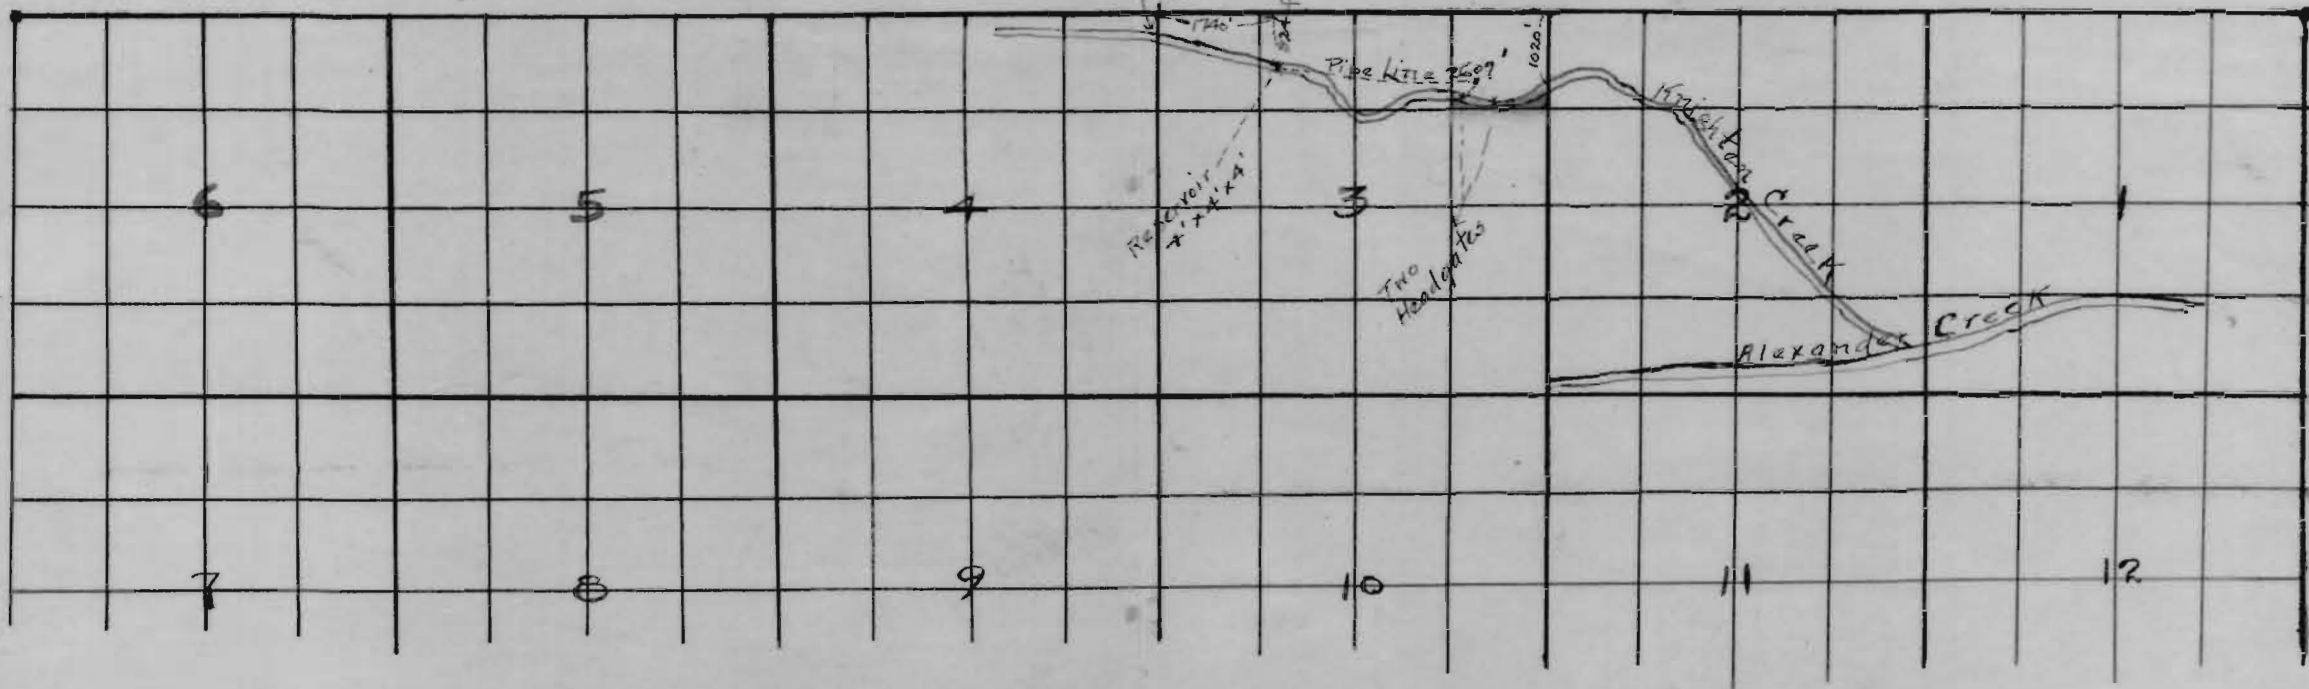

Amended Map

Application No. 9894  
Permit No. 6555

HP 89