


# SURVEYORS CERTIFICATE

I, W.E. Anderson a deputy Co. Surveyor of Tillamook Ore. do hereby certify that this map was made from notes taken during an actual survey made by me under the direct supervision of W.S. Coates Co. Engr. and that it correctly represents the location of the works together with streams and pipe lines

Deputy Co. Surv.

W.E. Anderson

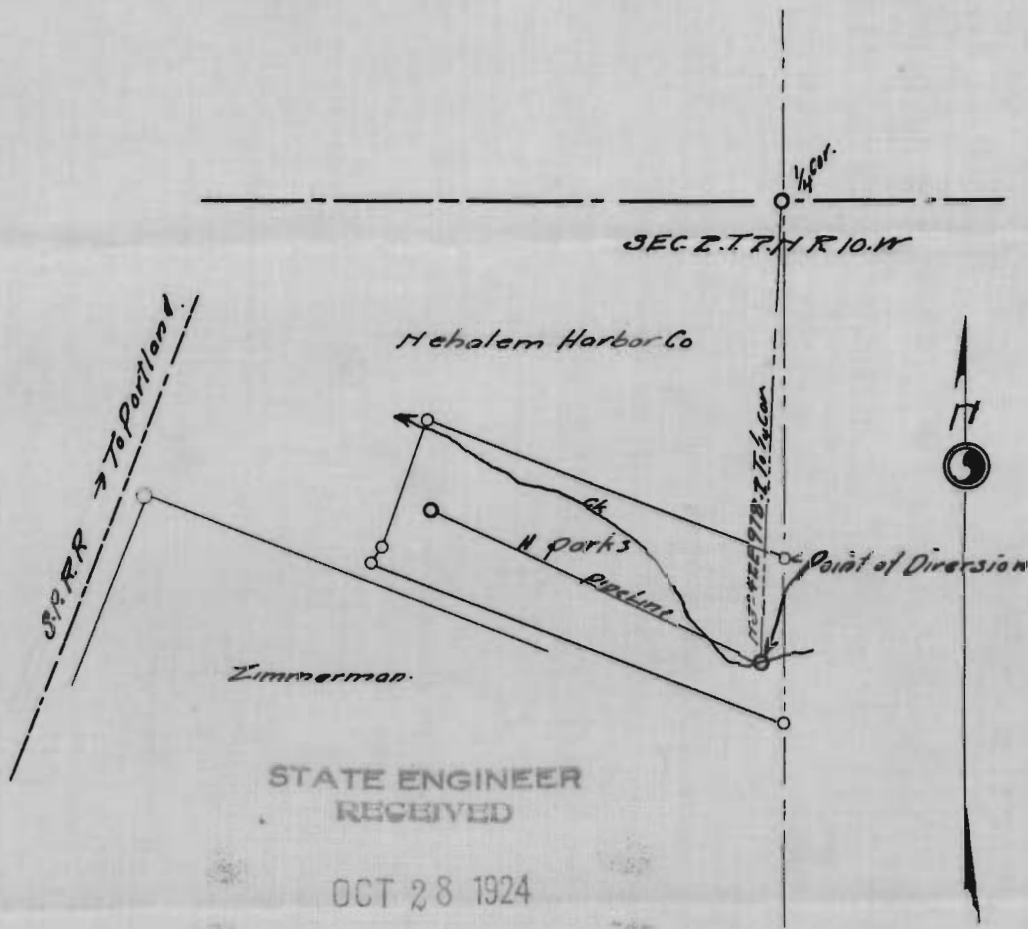

STATE ENGINEER  
RECEIVED

OCT 28 1924

SALEM OREGON

Application No.  
Permit No.

9908  
6598

PLAT

OF  
H. PARK'S WATER RIGHT  
SEC 2. T. 7. N. R. 10. W. W. M.  
Scale 1" = 400