


W

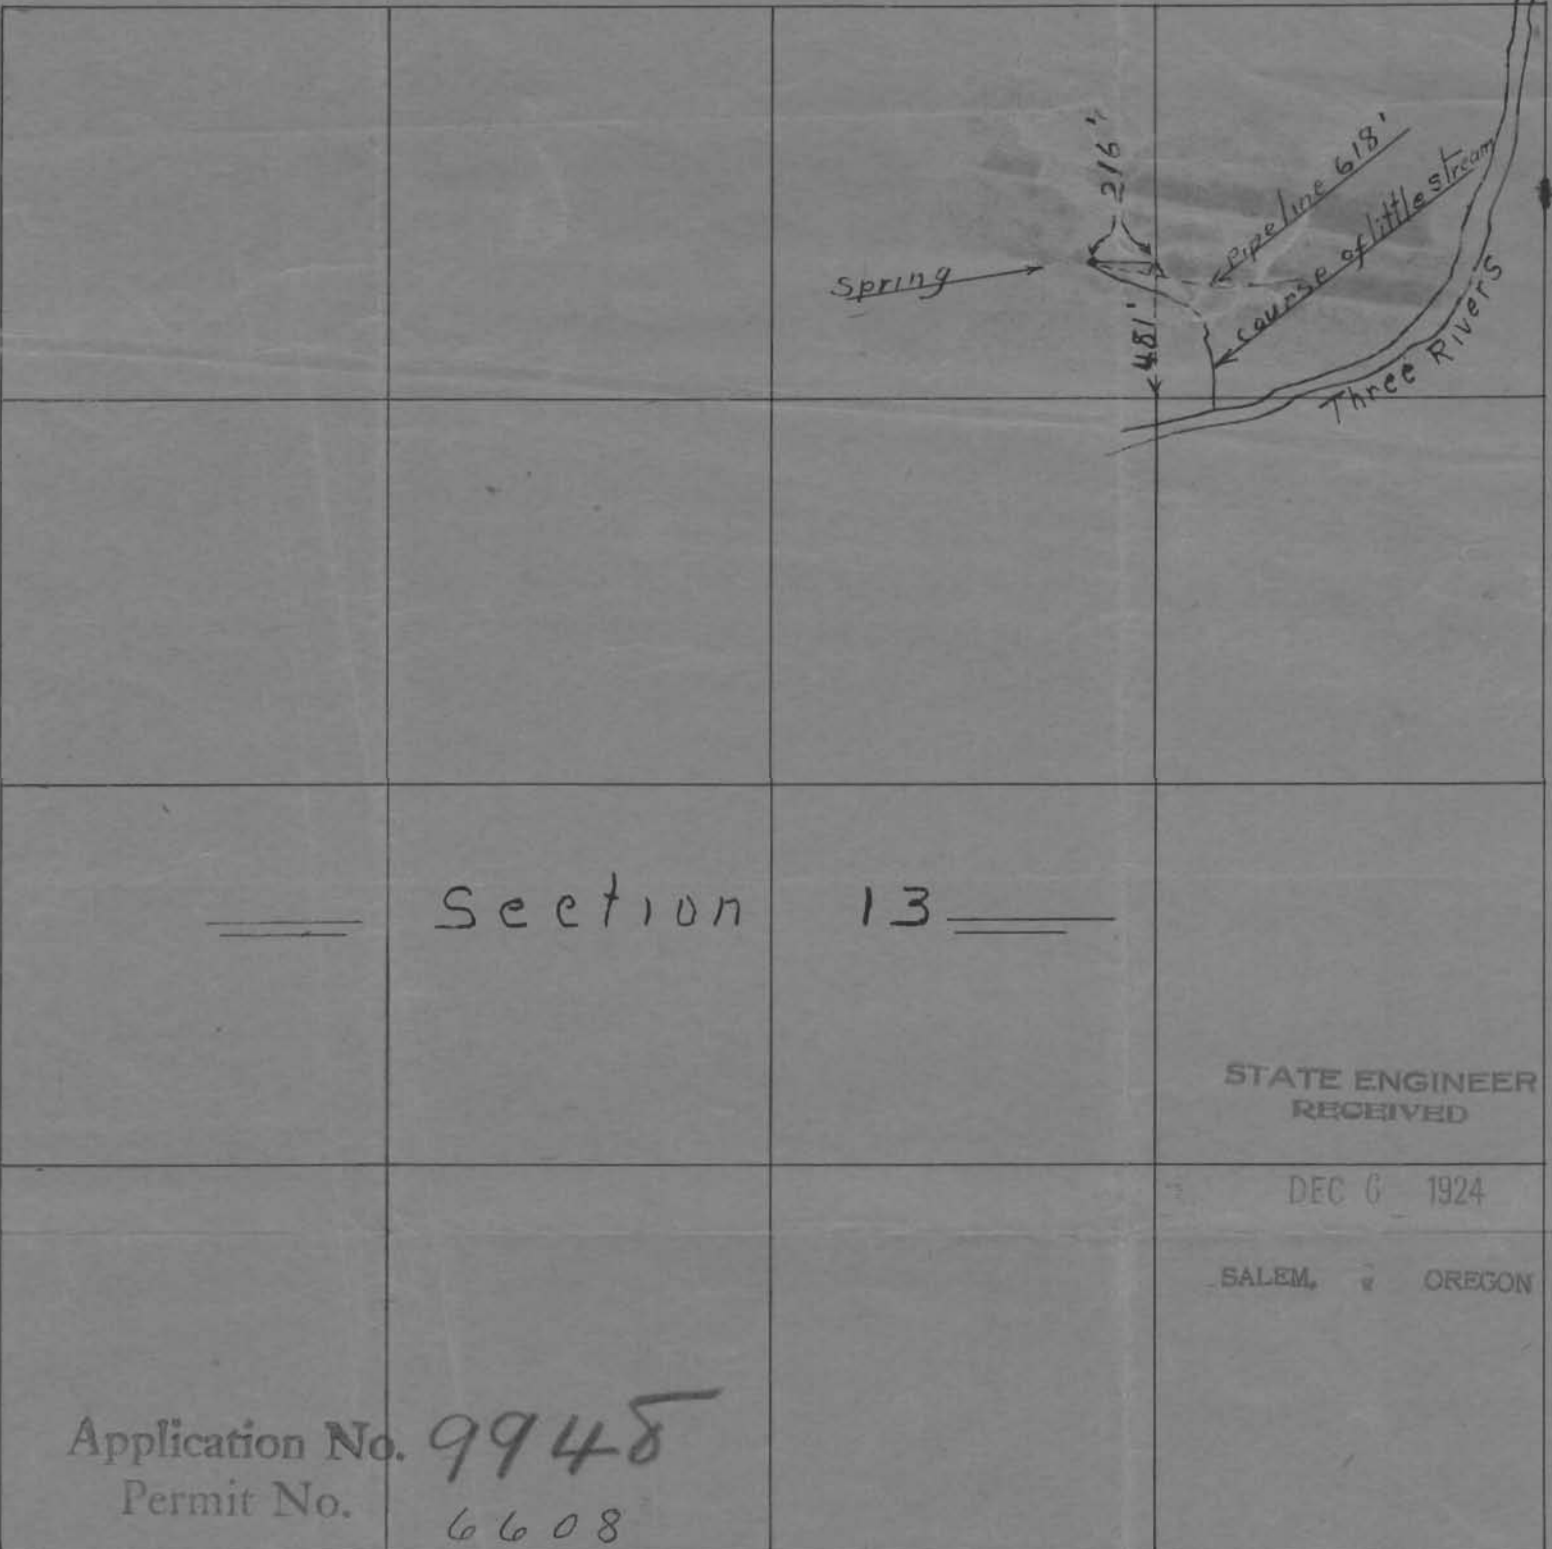

S

N

Spring located in S-W-<sup>4</sup> of N-W-<sup>4</sup> of Sec. 13 - Tp. 4 - S - R - 10 W

F