


9721

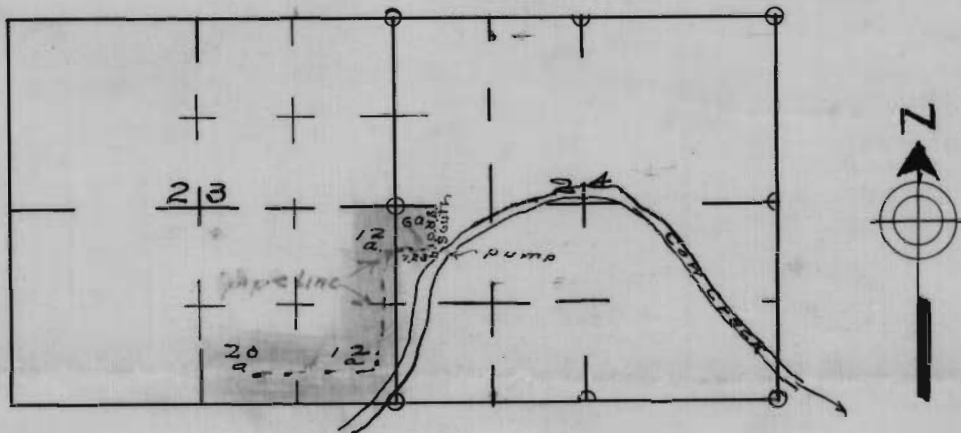

WOLLENBURG PUMP.

SEC., 24

T.30S. R6W.

Application No. 9721 *scale 40 chains to 1 inch.*

Permit No. 6612