



Township 6 N, Range 35 E.W.M.

9927

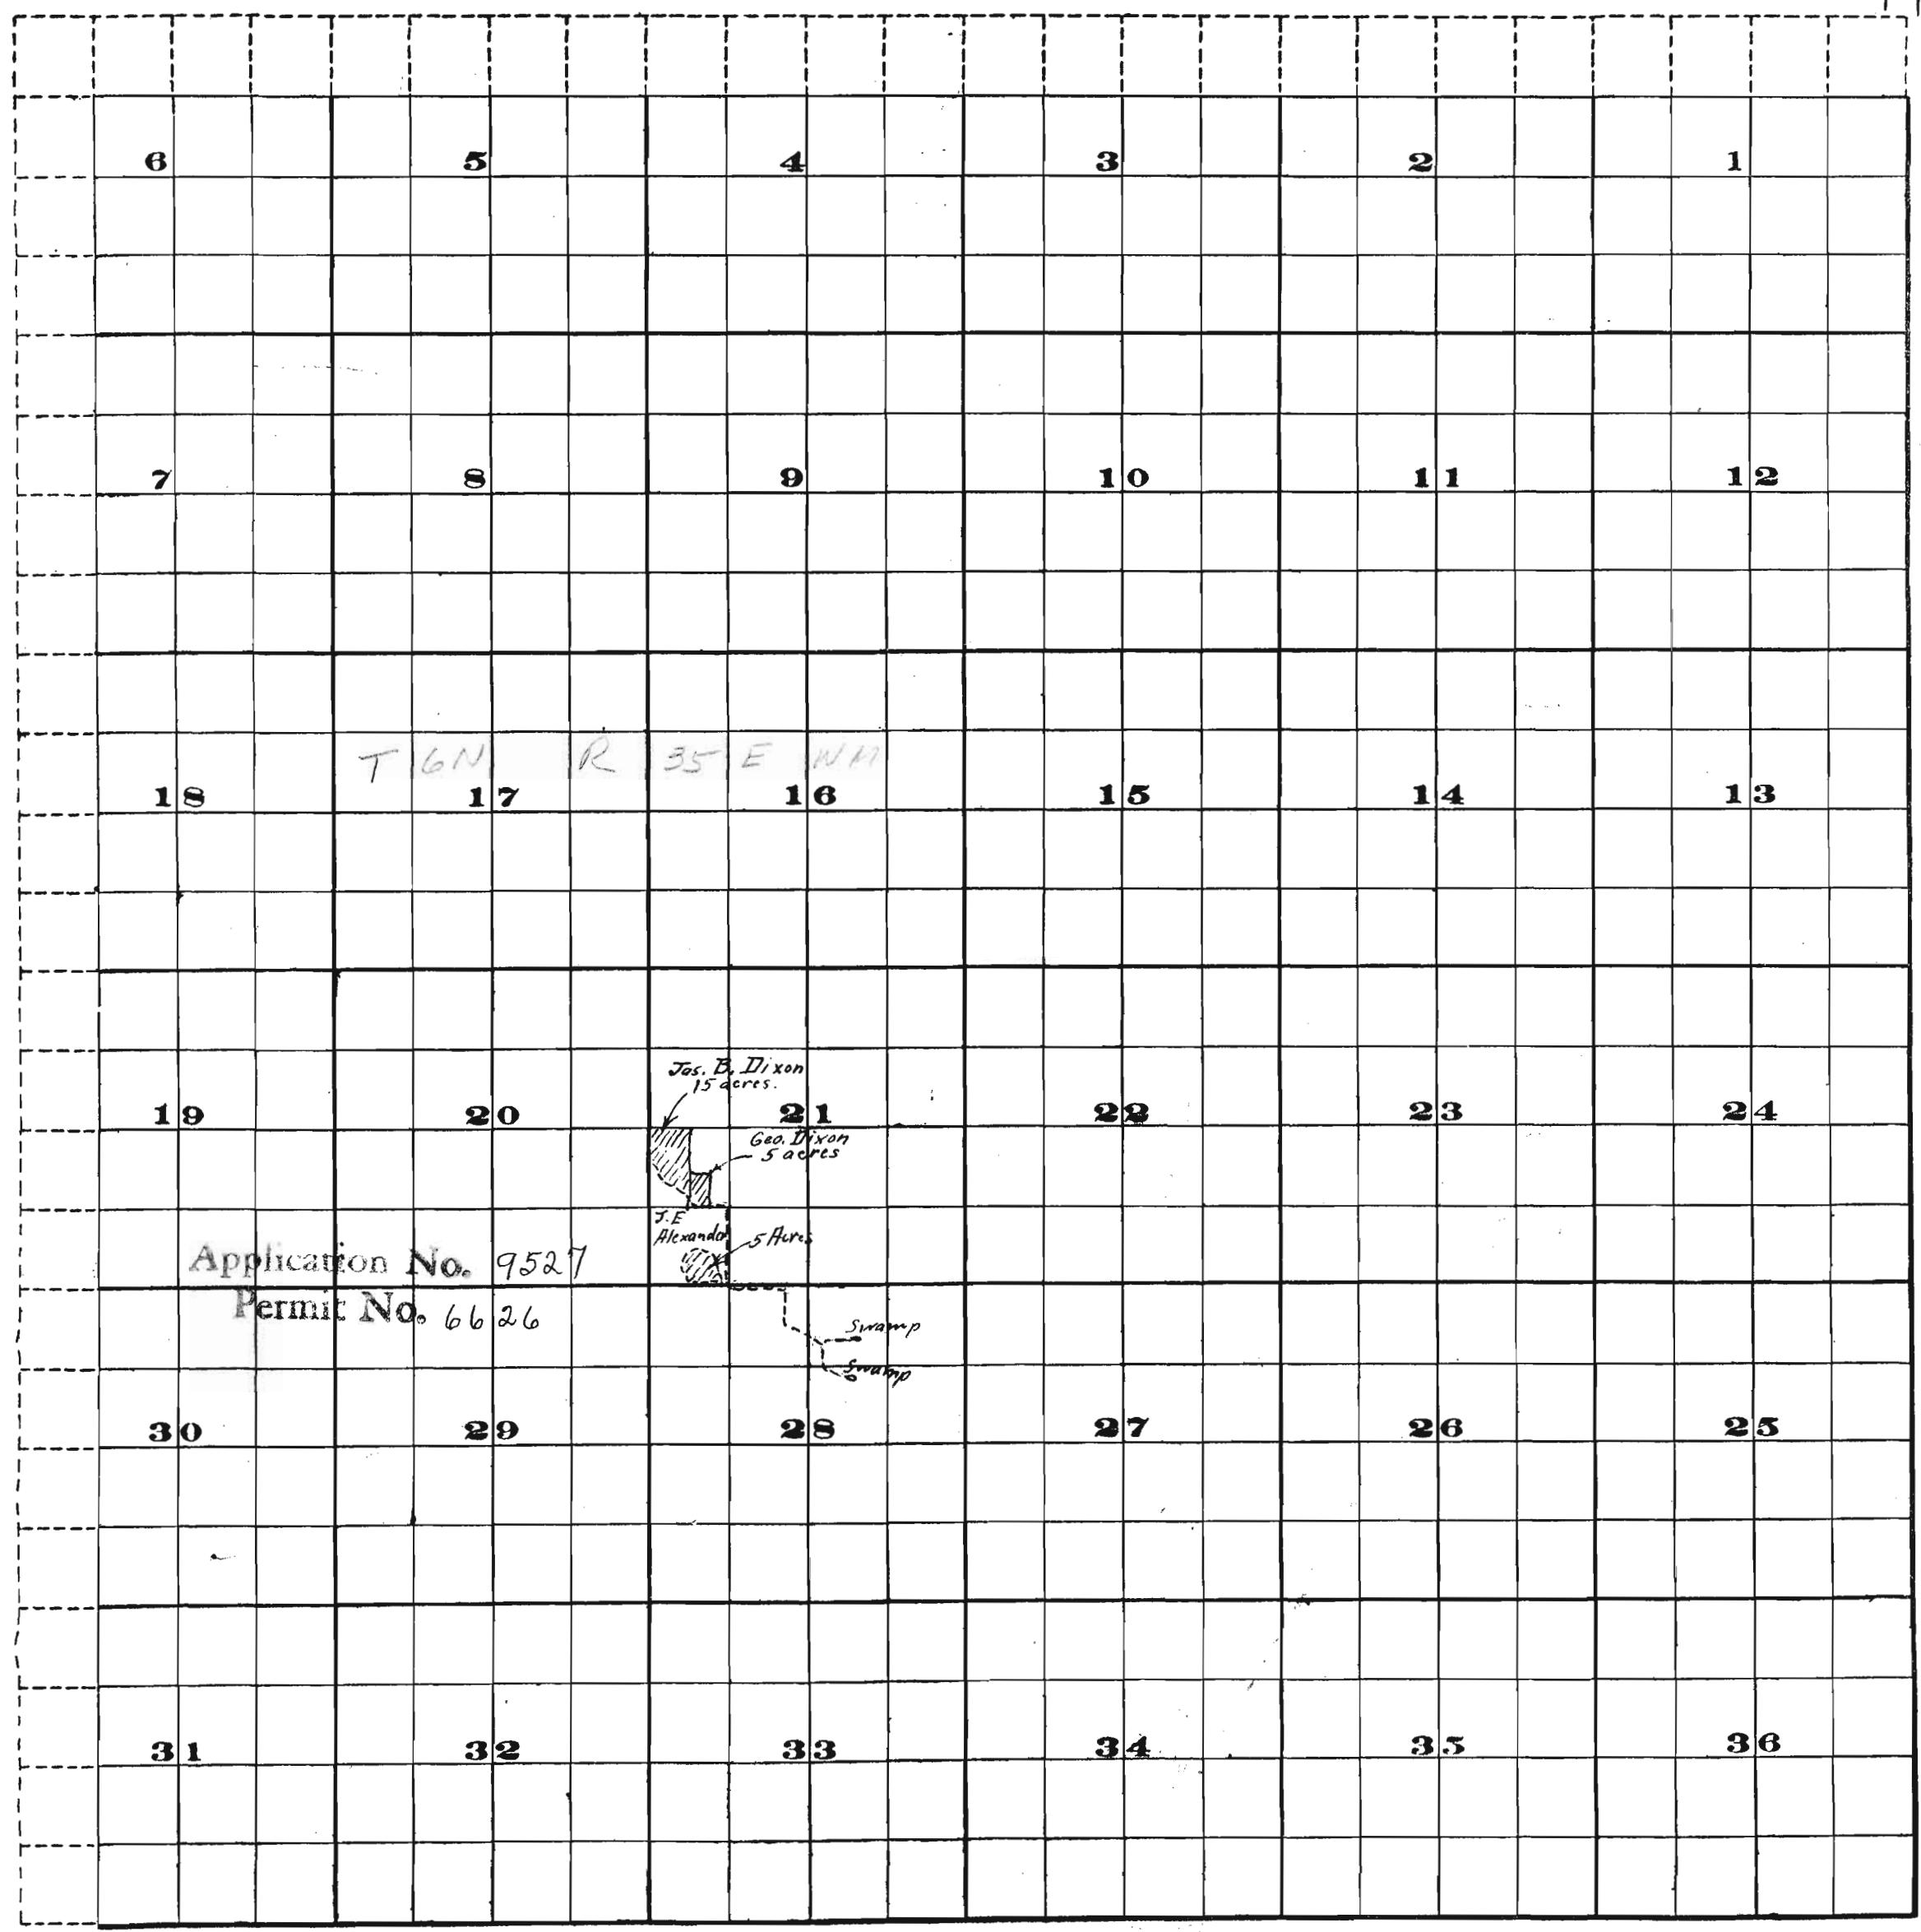

Application No.
9527.

Application No. 9527
Permit No. 6626

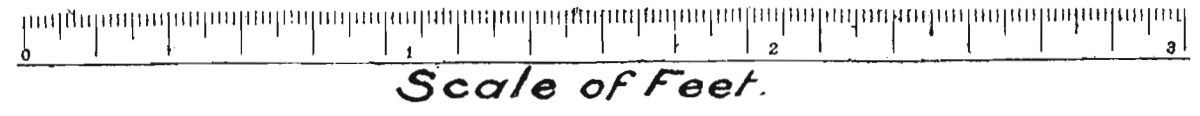

9527