


SURVEYOR'S CERTIFICATE

I, W.E. Anderson of Tillamook County, do hereby certify that this map was made from notes taken during an actual survey made by me in June, 1924, under the direct supervision of H.S. Coates Co. Engr of Tillamook County, and that it correctly represents the location of streams and other works herein shown.

W.E. Anderson
Deputy Co. Engr

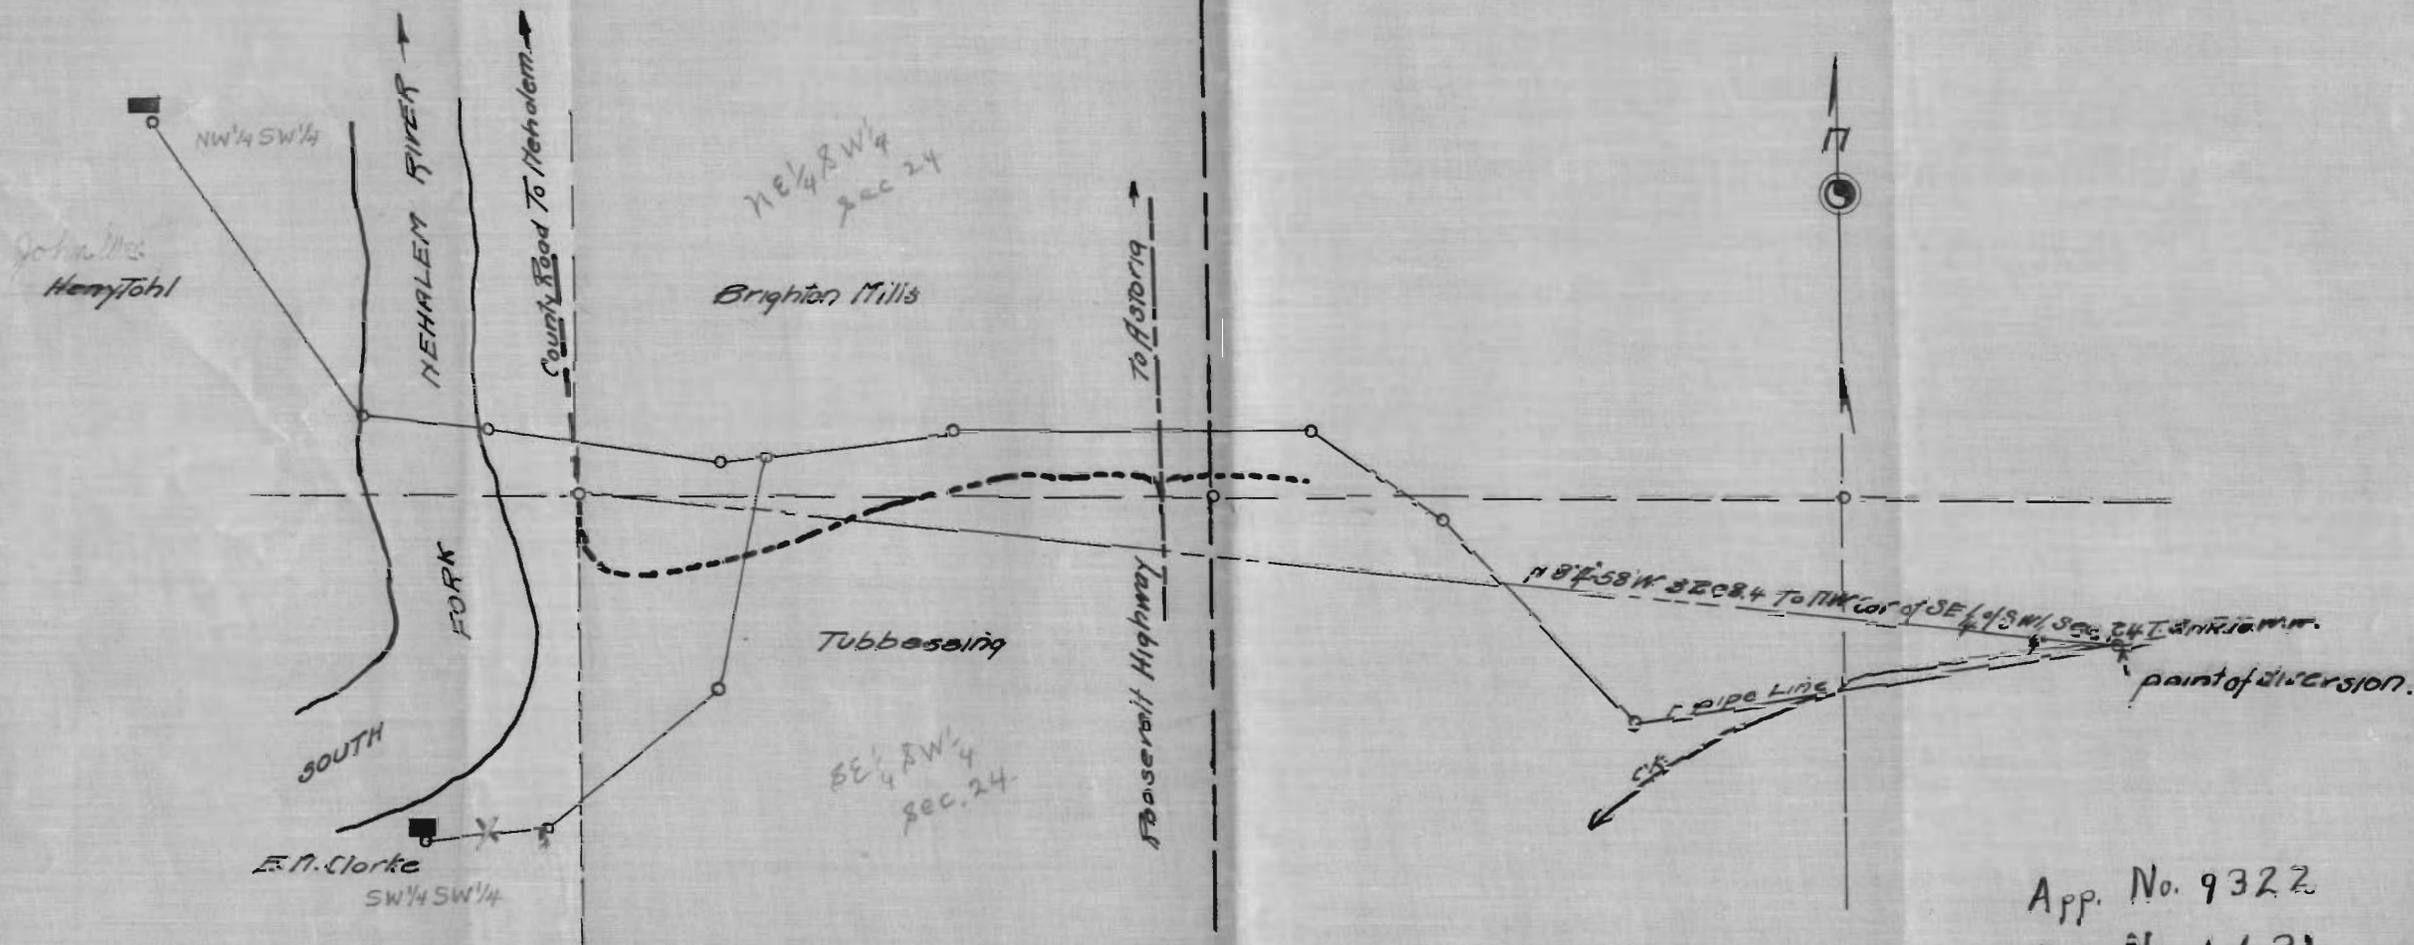

MAP
OF
John, Wm Henry Töhl and E.M. Clarke Water Right
Tillamook County Ore
Scale 1" = 400'

App. No. 9322
Per. No. 6631