


App. 10053

Sec. 29  
\_\_\_\_\_  
\_\_\_\_\_  
\_\_\_\_\_  
Tp. 2 N.  
R. 7 E.

Commencing at  
Center Sect 29  
Running East  
on Sect line 264  
feet Then ~~Southwardly~~  
direction 190 ft  
to Spring  
Pike <sup>to road</sup> & Spring  
to Dwellings  
about 275 feet  
~~Southwardly~~ NORTHERLY  
direction  
in lot 2.

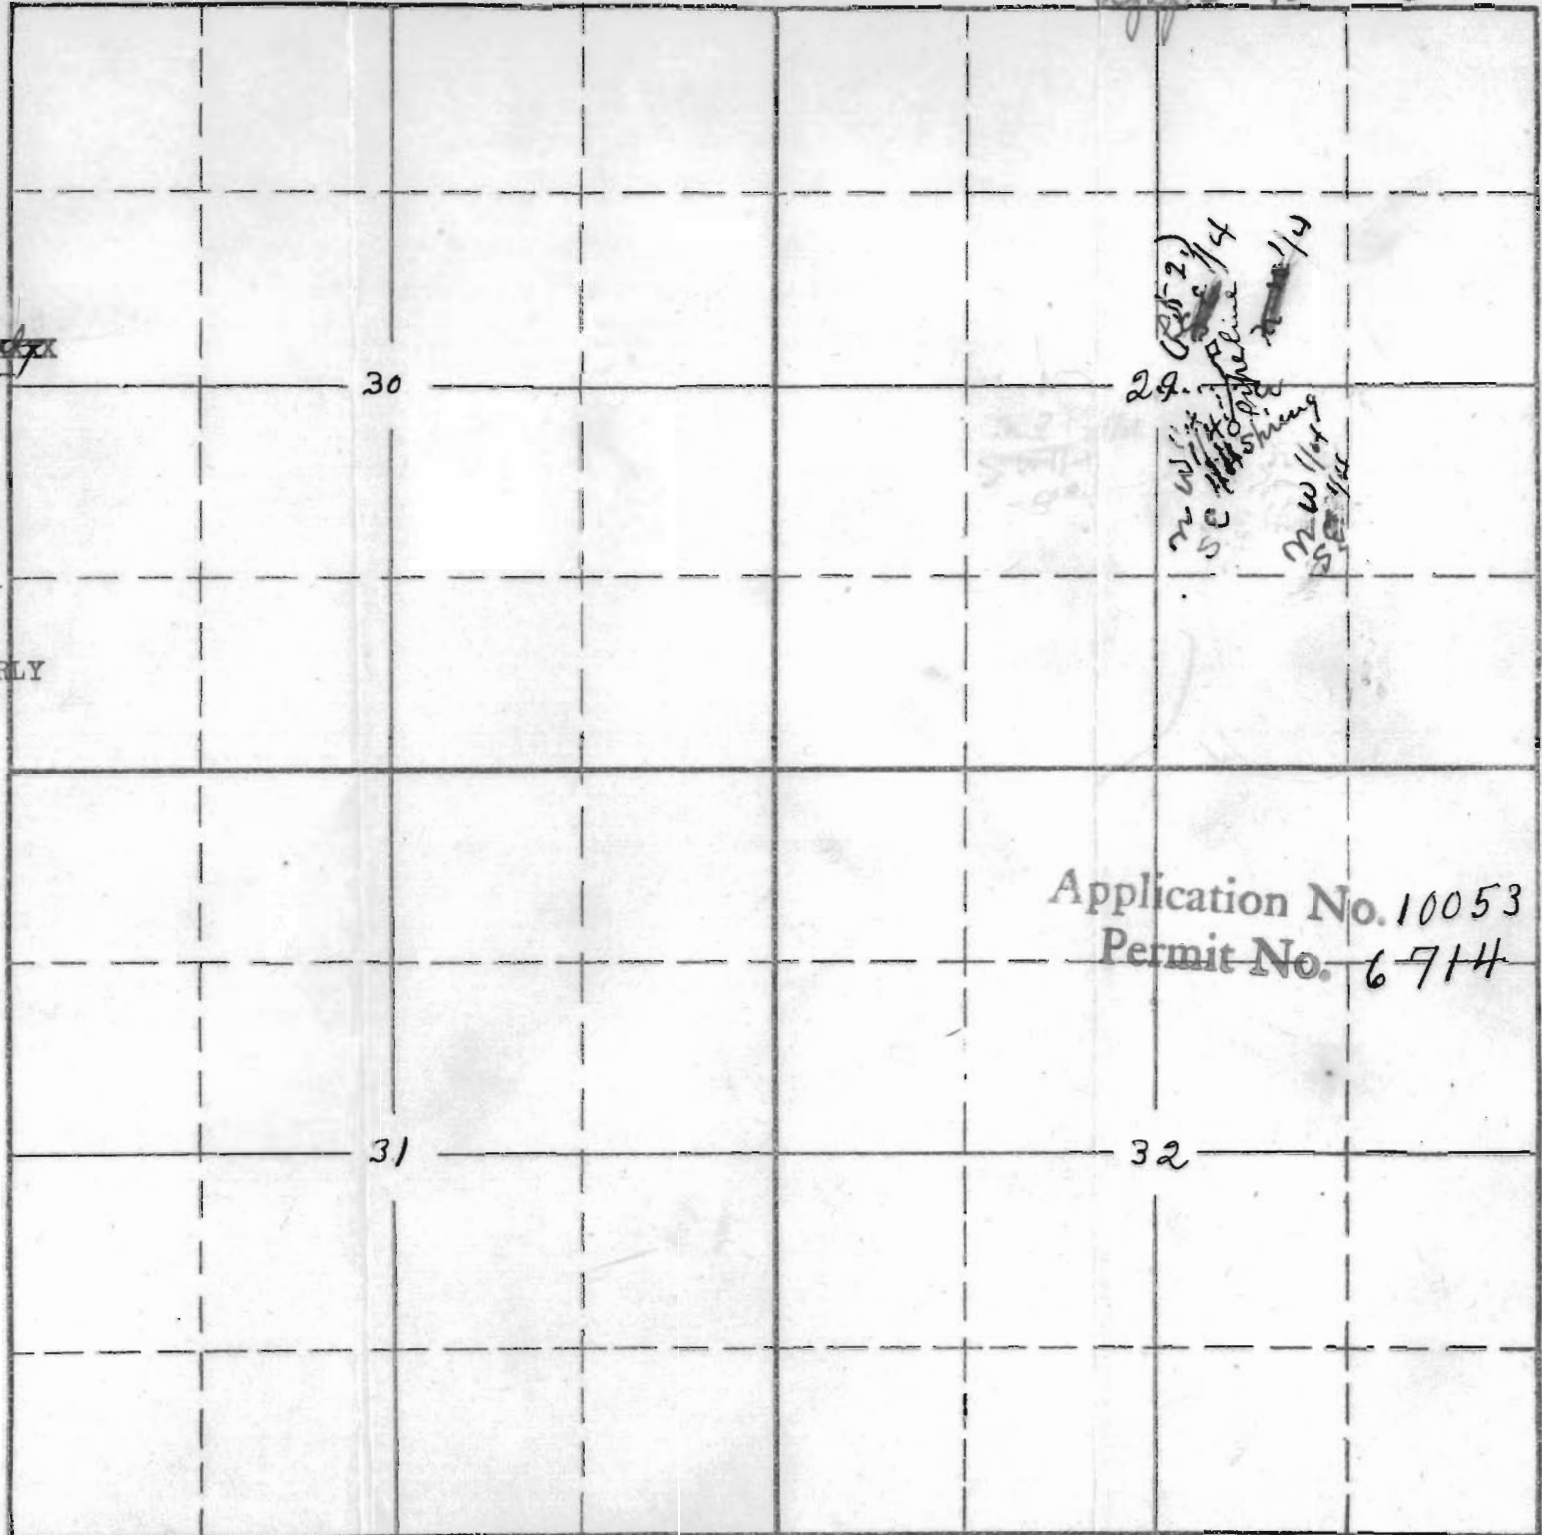

29. 1/4  
M W 1/4  
SE 1/4  
M W 1/4  
SE 1/4

Application No. 10053  
Permit No. 6714

30

31

32