


Township 6 North, Range 35 E.W.M.

Applicants Exhibit "A"


STATE ENGINEER
RECEIVED
NOV 7 1924
SALEM, OREGON

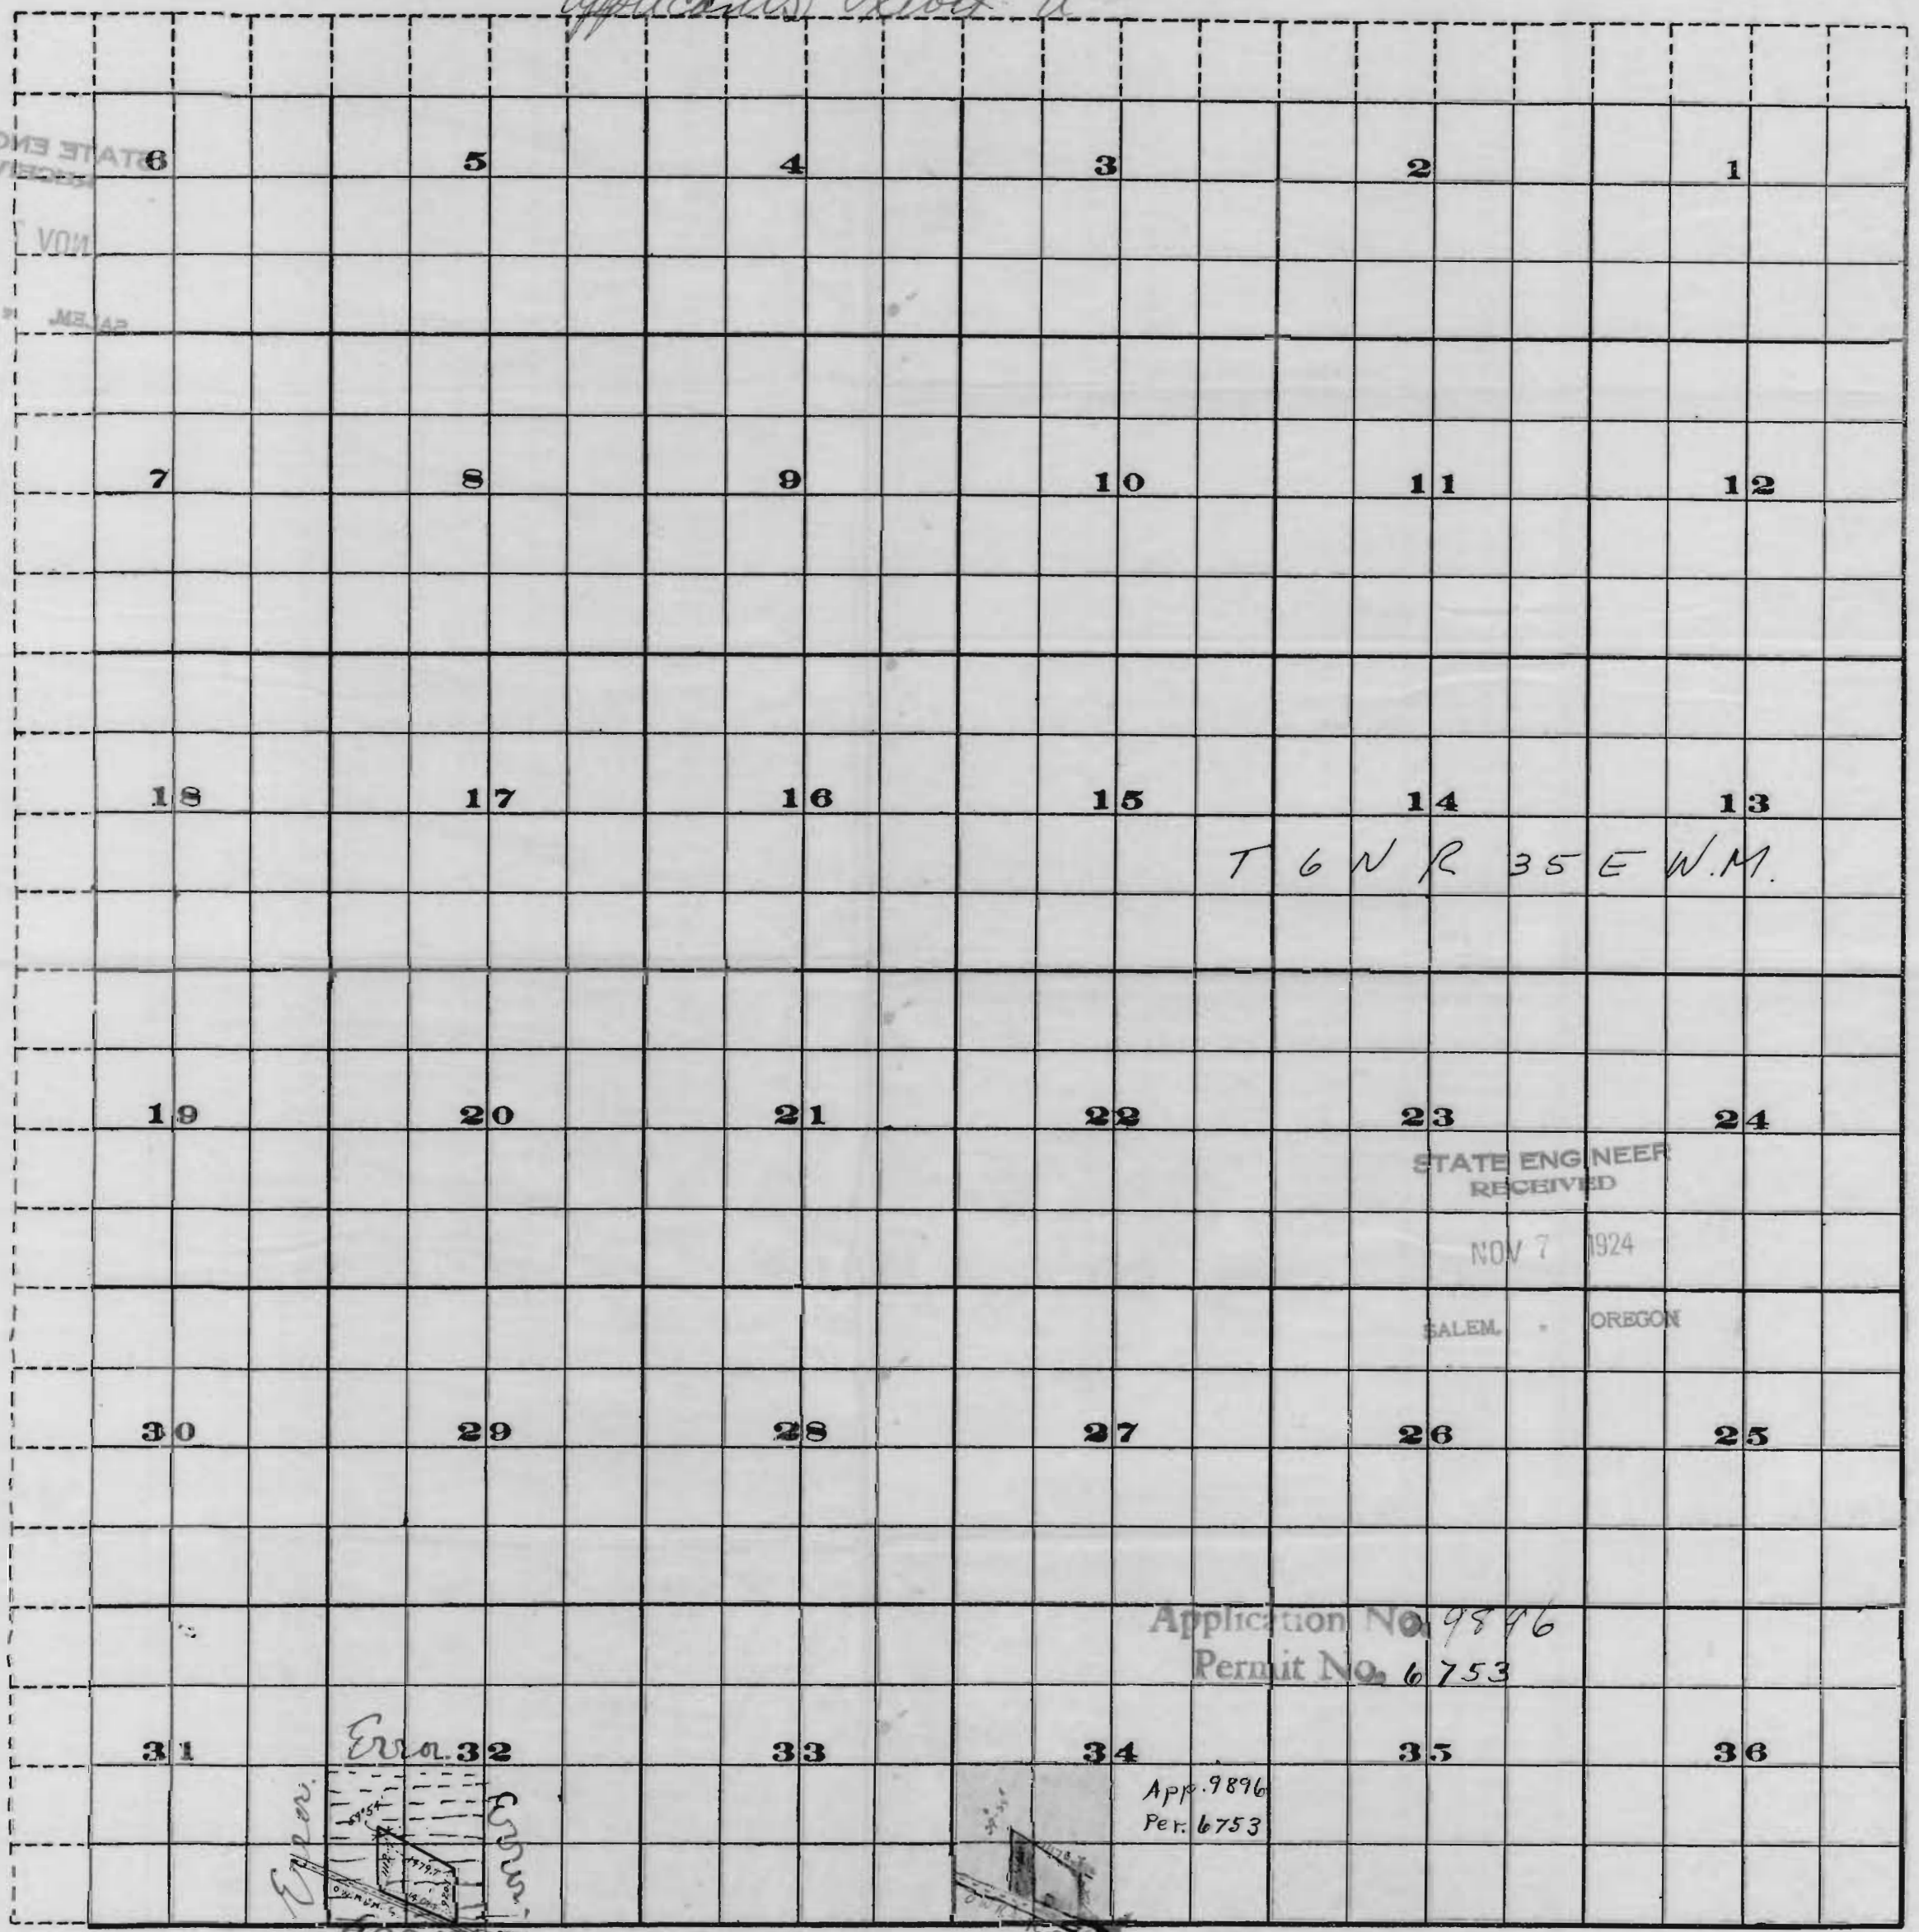

STATE ENGINEER
RECEIVED
NOV 7 1924
SALEM, OREGON

Application No. 9896
Permit No. 6753

App. 9896
Per. 6753

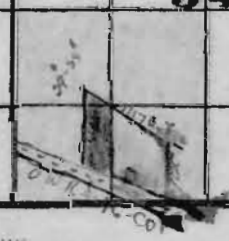

Scale of Feet.

FROM OFFICE OF THE STATE ENGINEER, SALEM, OREGON

indicates the 10 acrs. to be irrigated
no. 4 } in SE⁴ of Sec. 34 - Twp. 6 - Range 35
about 910 feet N. & 60 feet E. of each
corner of division line.

7889

7889

9789