


Township 1 North,

Range 3 East.

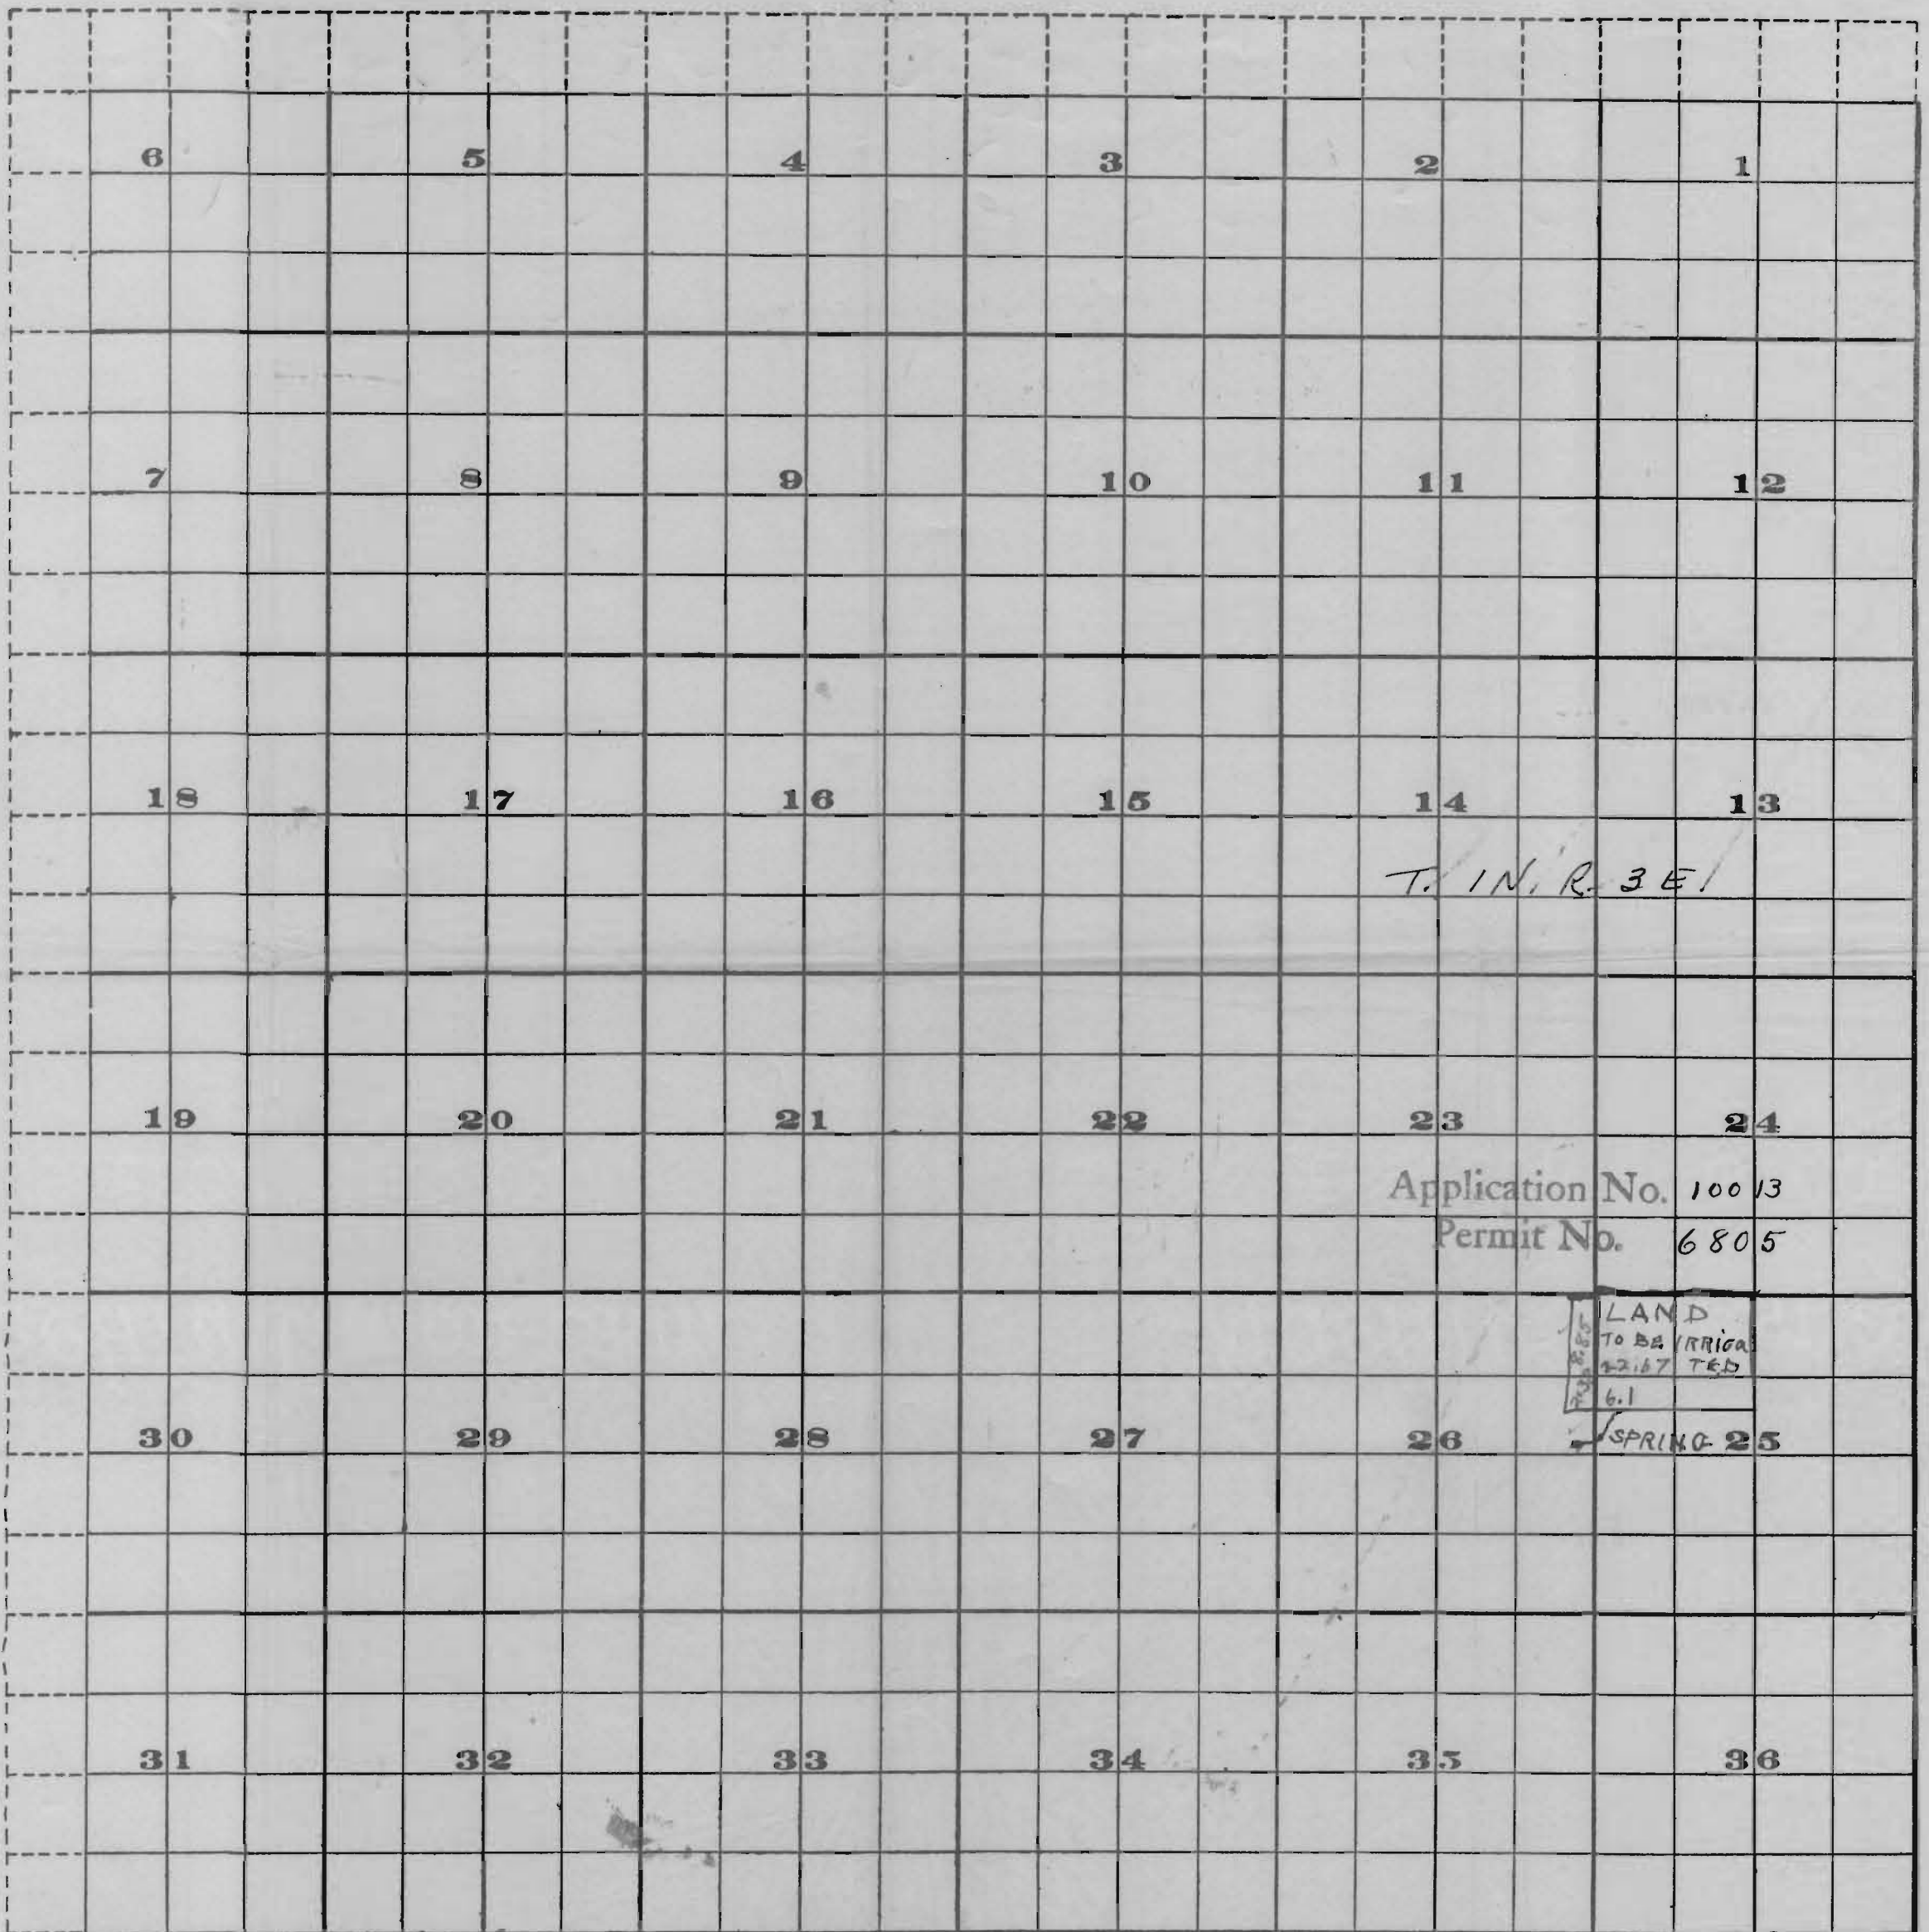

Application No. 10013

Permit No. 6805

LAND
TO BE IRRIGATED
42167 TED
6.1

SPRING 25



Scale of Feet.