



Township 33 S,

Range 1 E

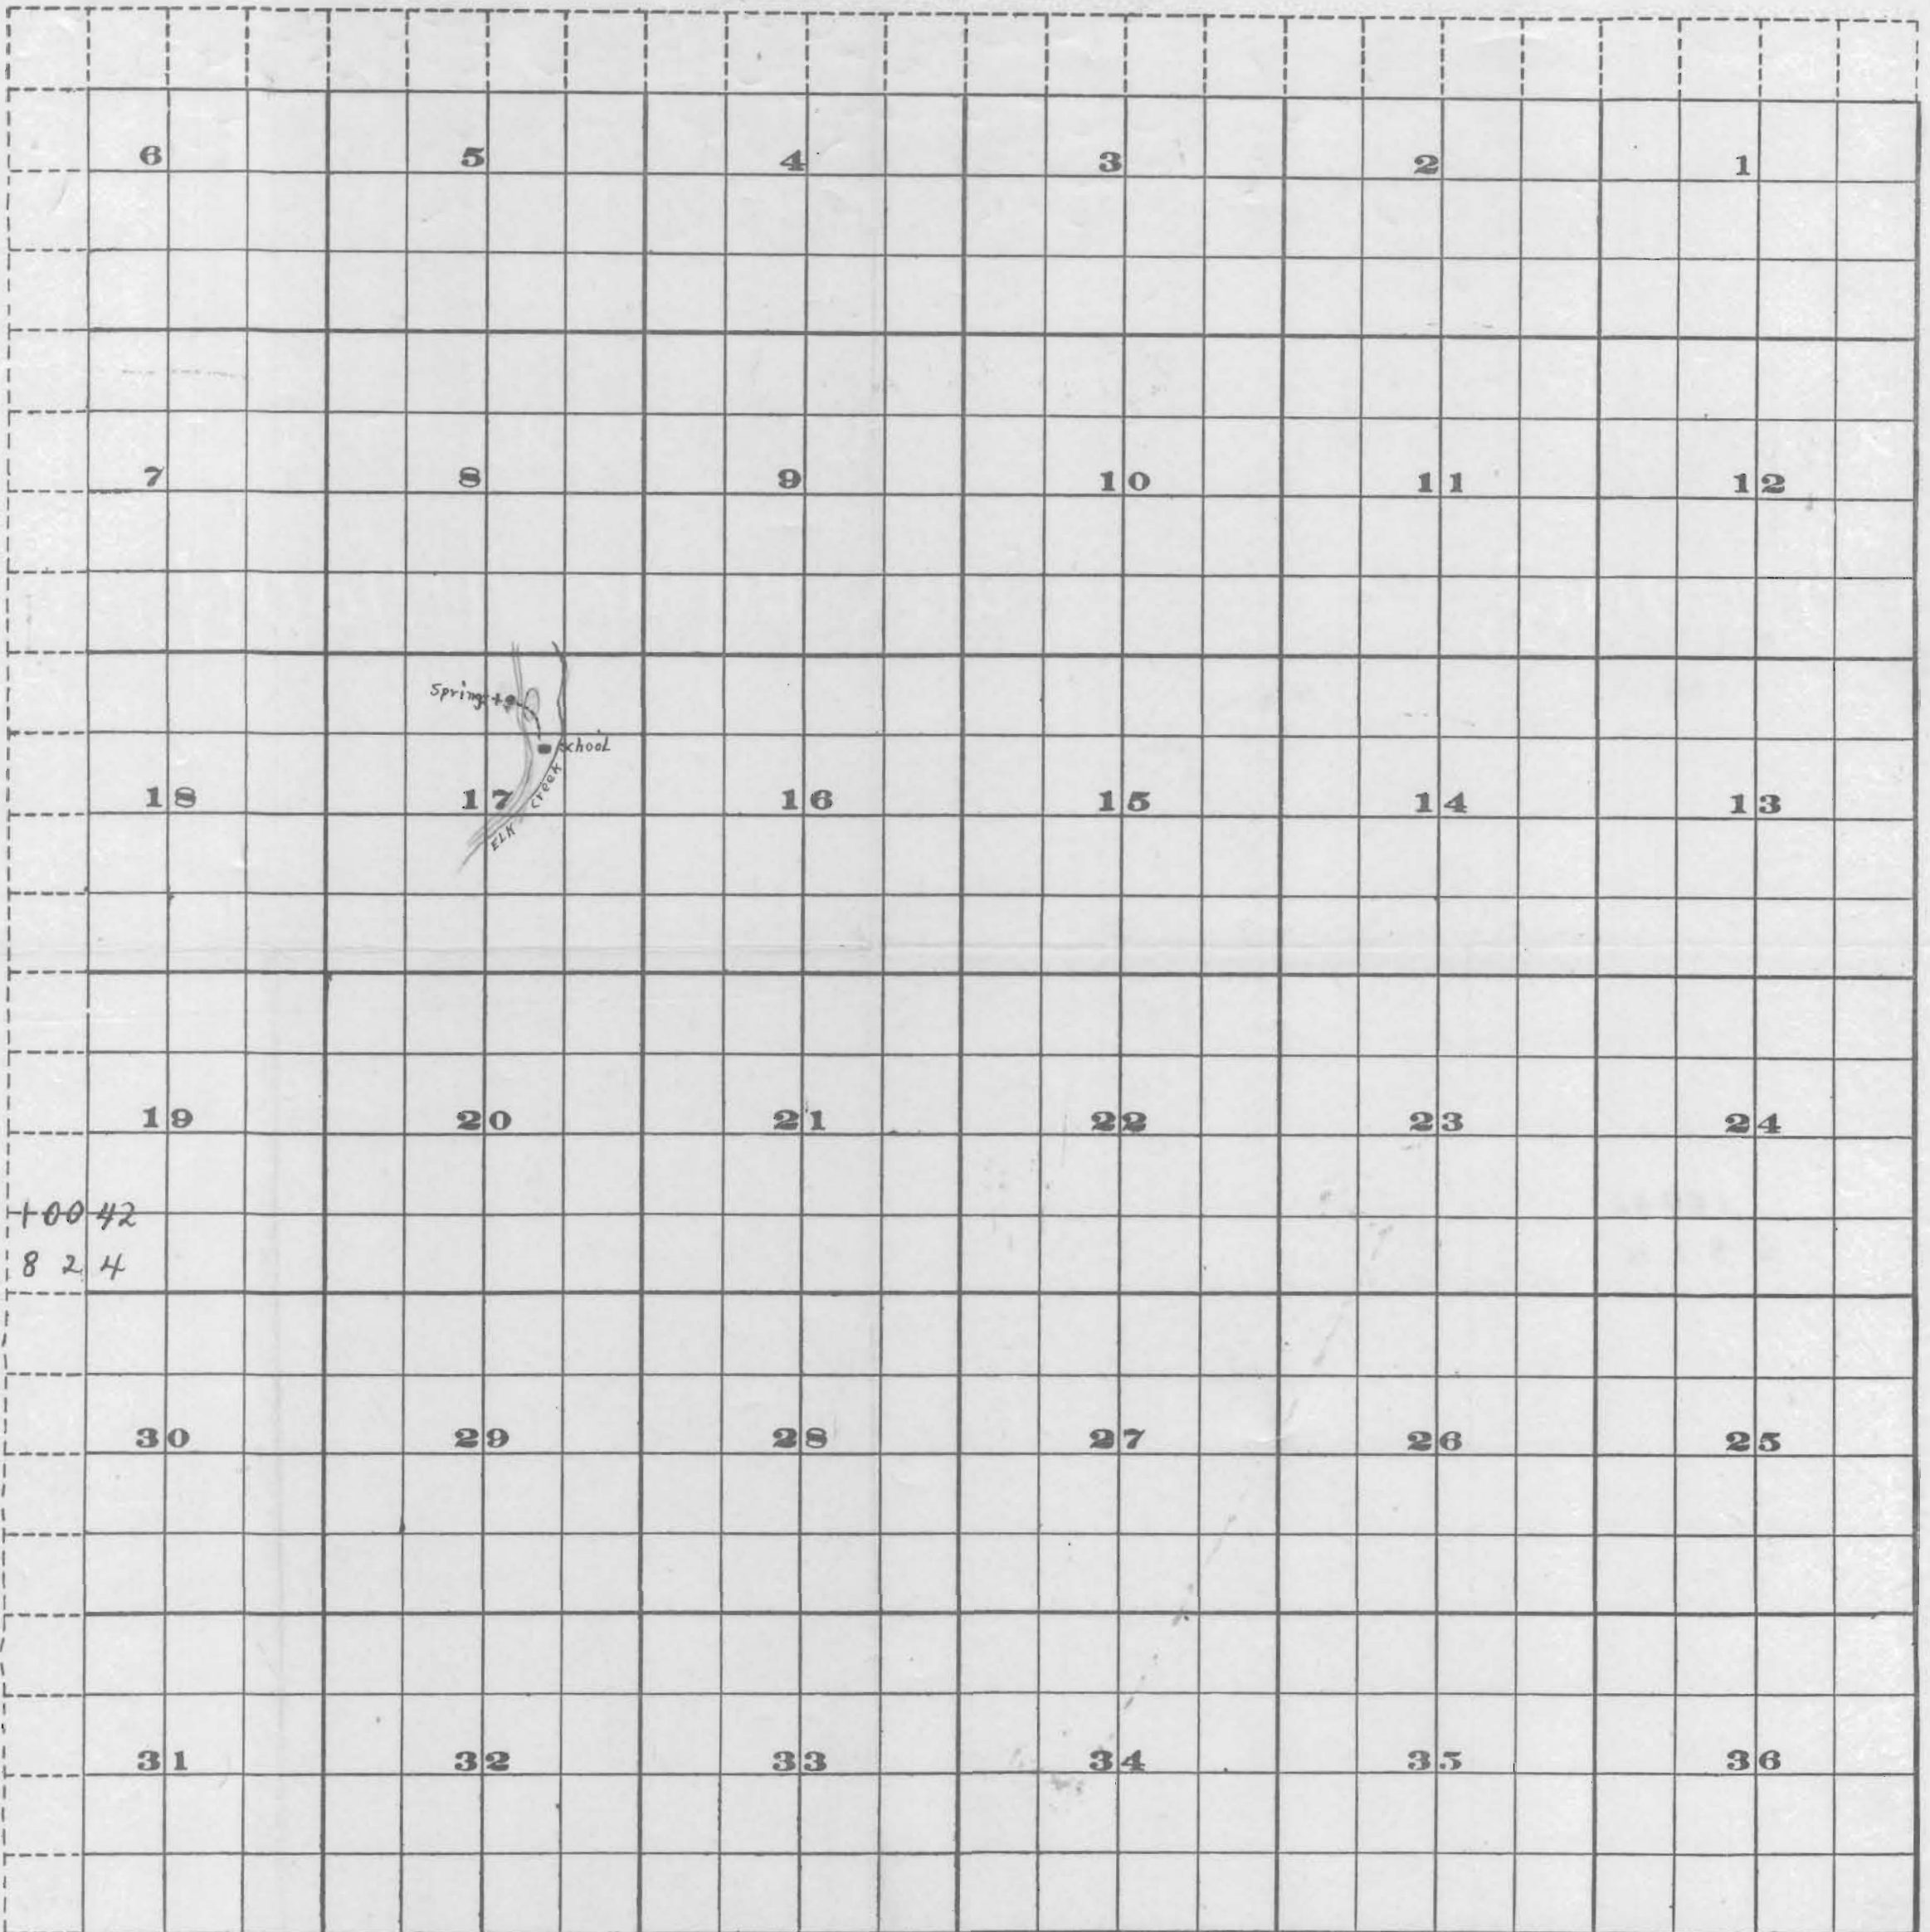

10042

Application No. 10042  
Permit No. 6824

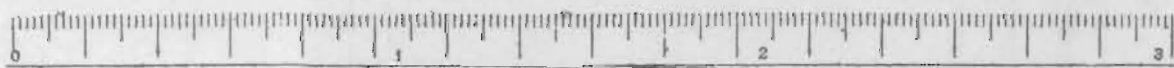

Scale of Feet.