


Township 32 So.

Range 5 West

W M

10315


10315

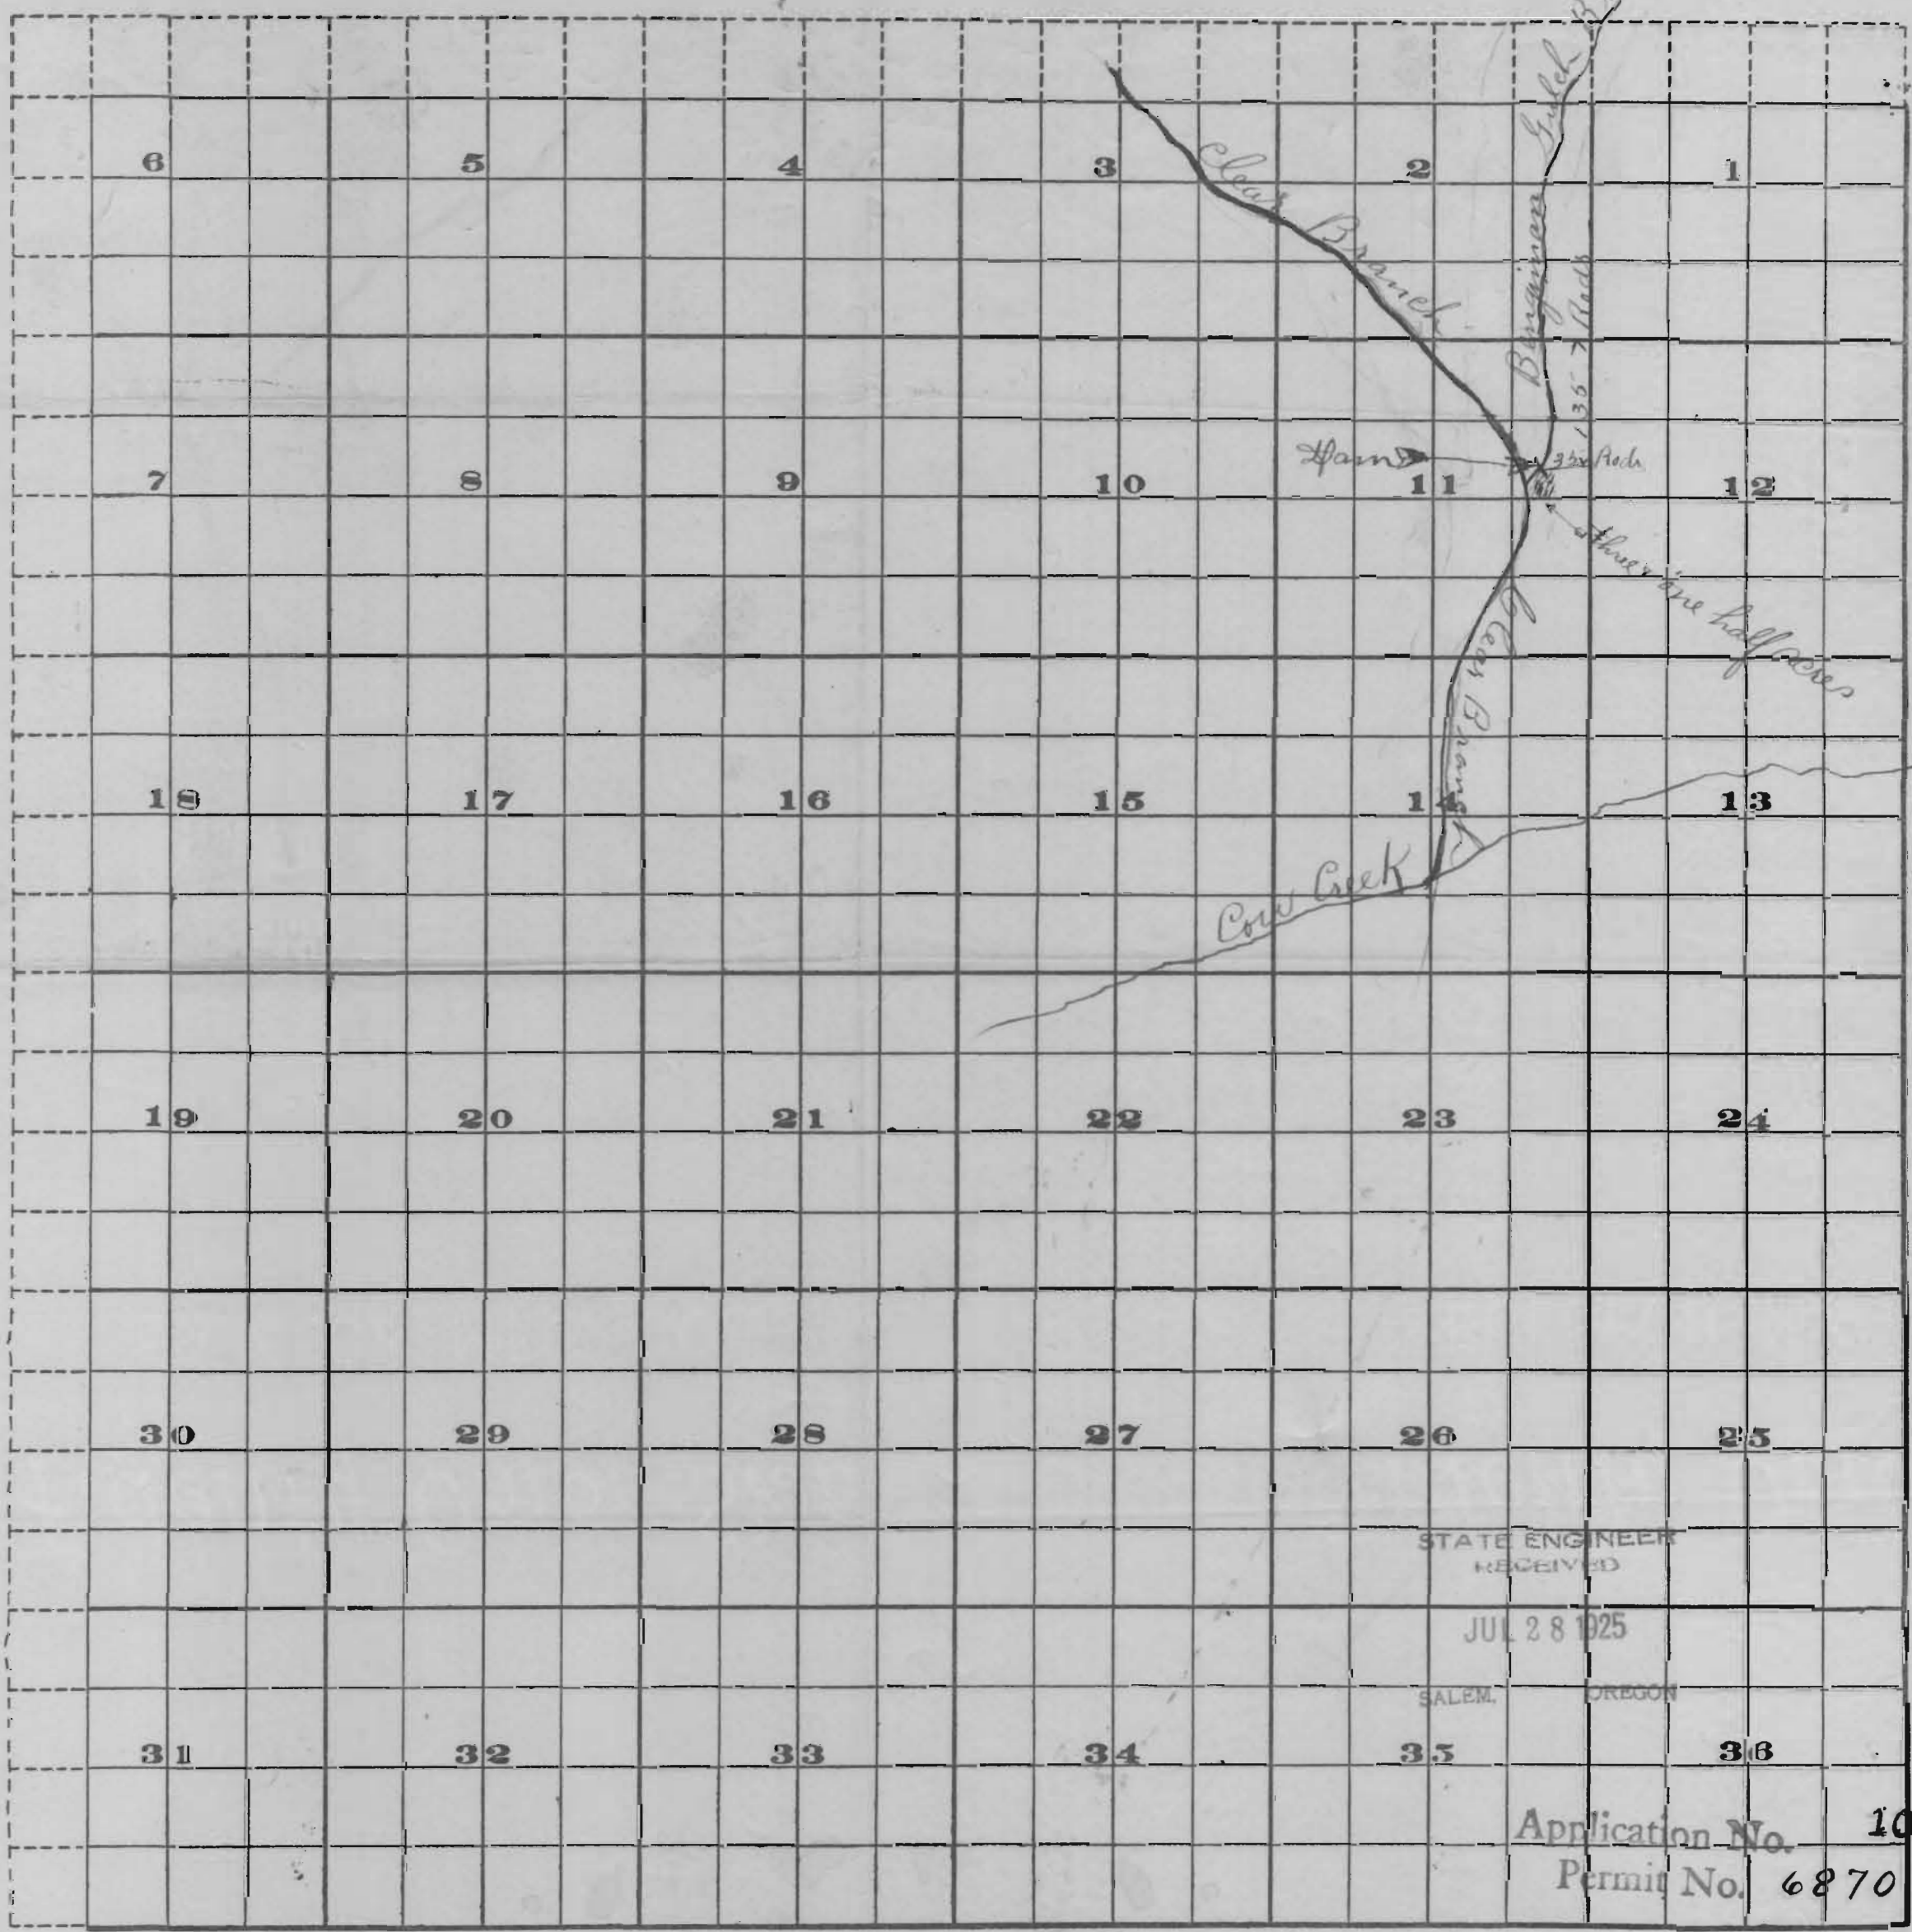

10315

STATE ENGINEER
RECEIVED
JUL 28 1925
SALEM, OREGON

Application No. 10312
Permit No. 6870

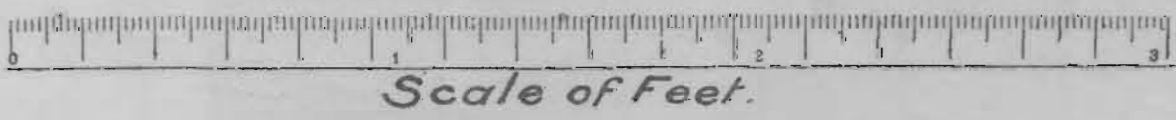

FROM OFFICE OF THE STATE ENGINEER, SALEM, OREGON

10315