


10330

Sec. 7
Tp. 18S
R. 45E

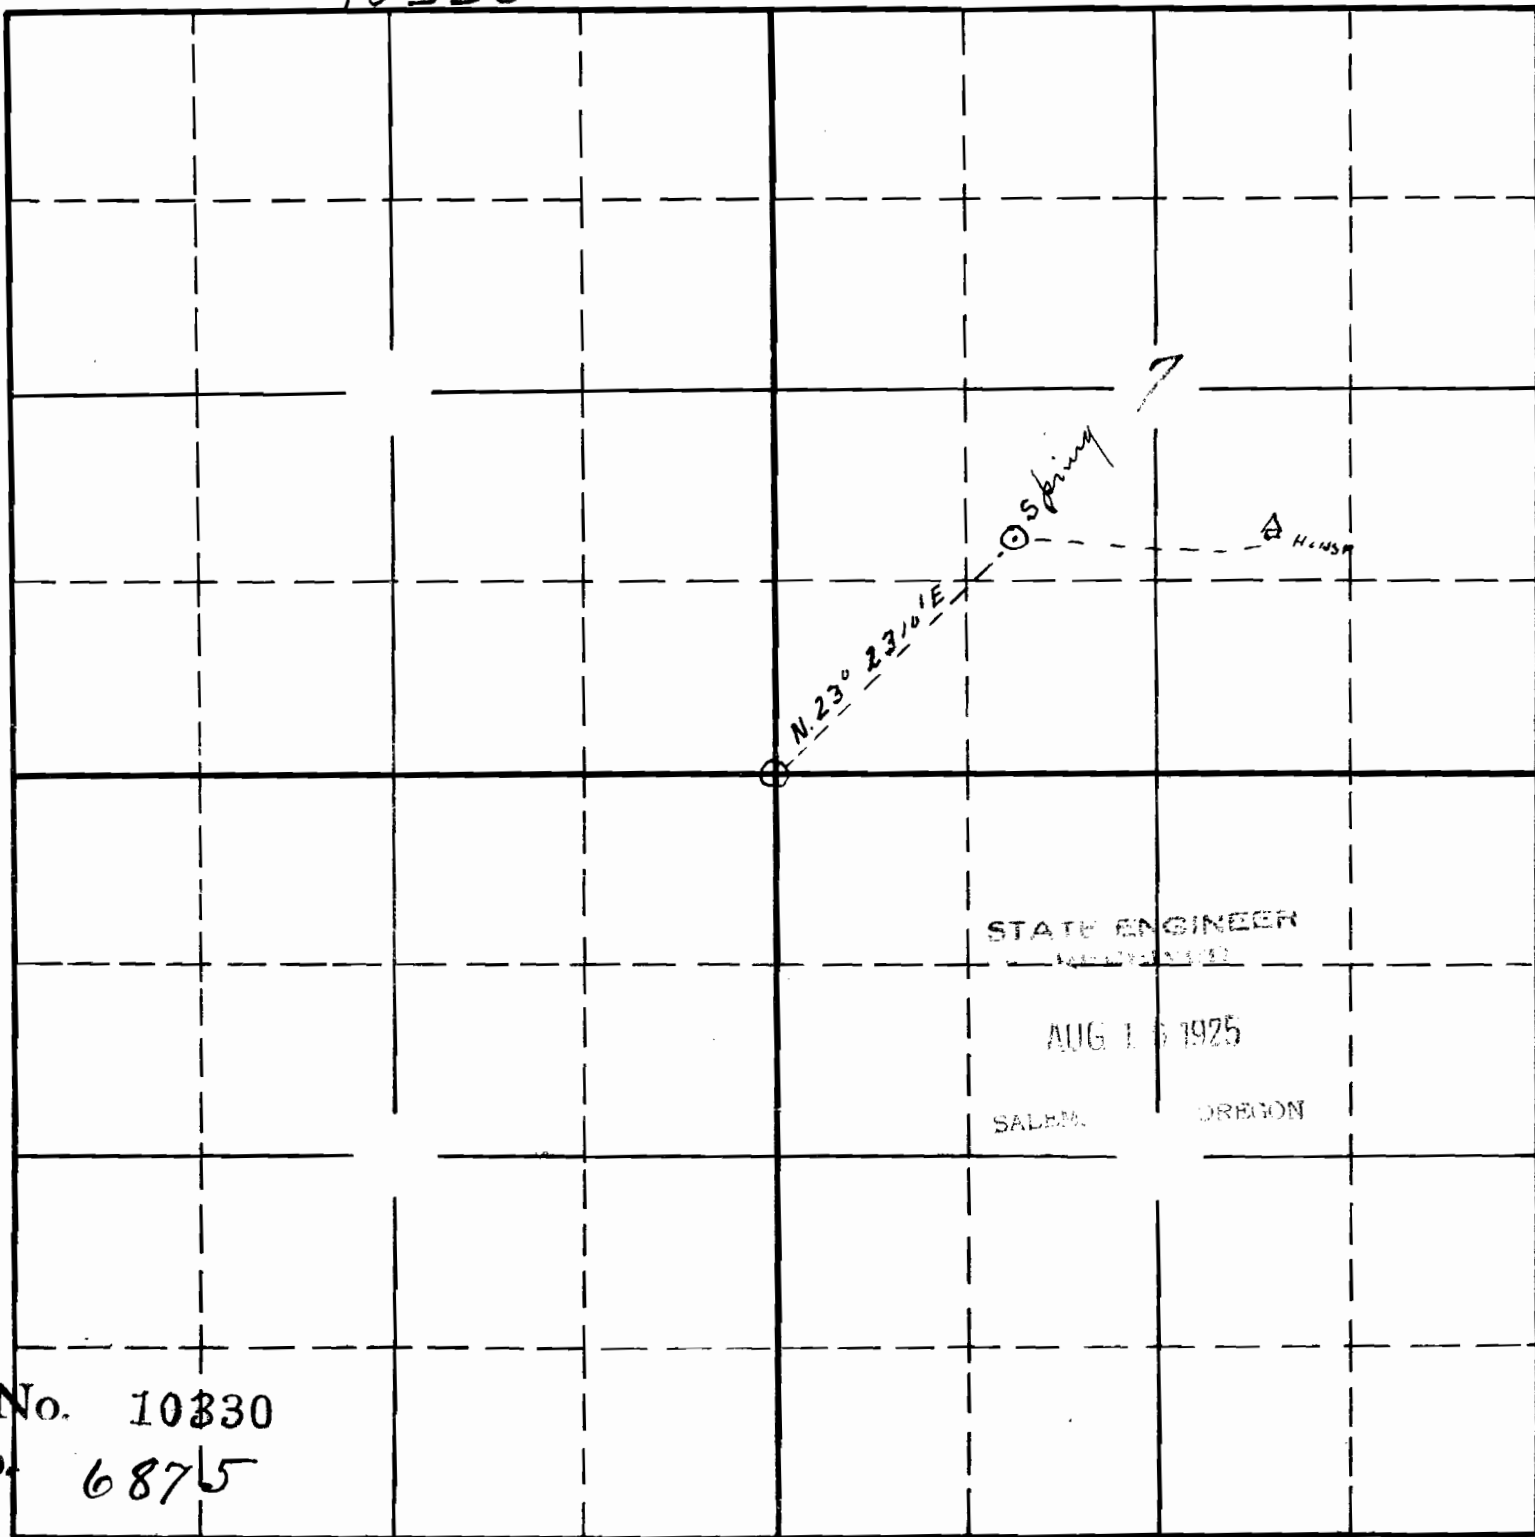

STATE ENGINEER

AUG 1 1925

SALEM OREGON

Application No. 10330
Permit No. 6875