


10394

SURVEYOR'S CERTIFICATE

I, W.E. Anderson a deputy surveyor of Tillamook Ore. do hereby certify that this map was made from notes taken during an actual survey made by me Aug. 28, 1924, under the direct supervision of W.S. Coates, Co. Engineer of Tillamook Co. and that it correctly represents the location of the works and pipe line herein shown.

Deputy Co Engineer
W.E. Anderson

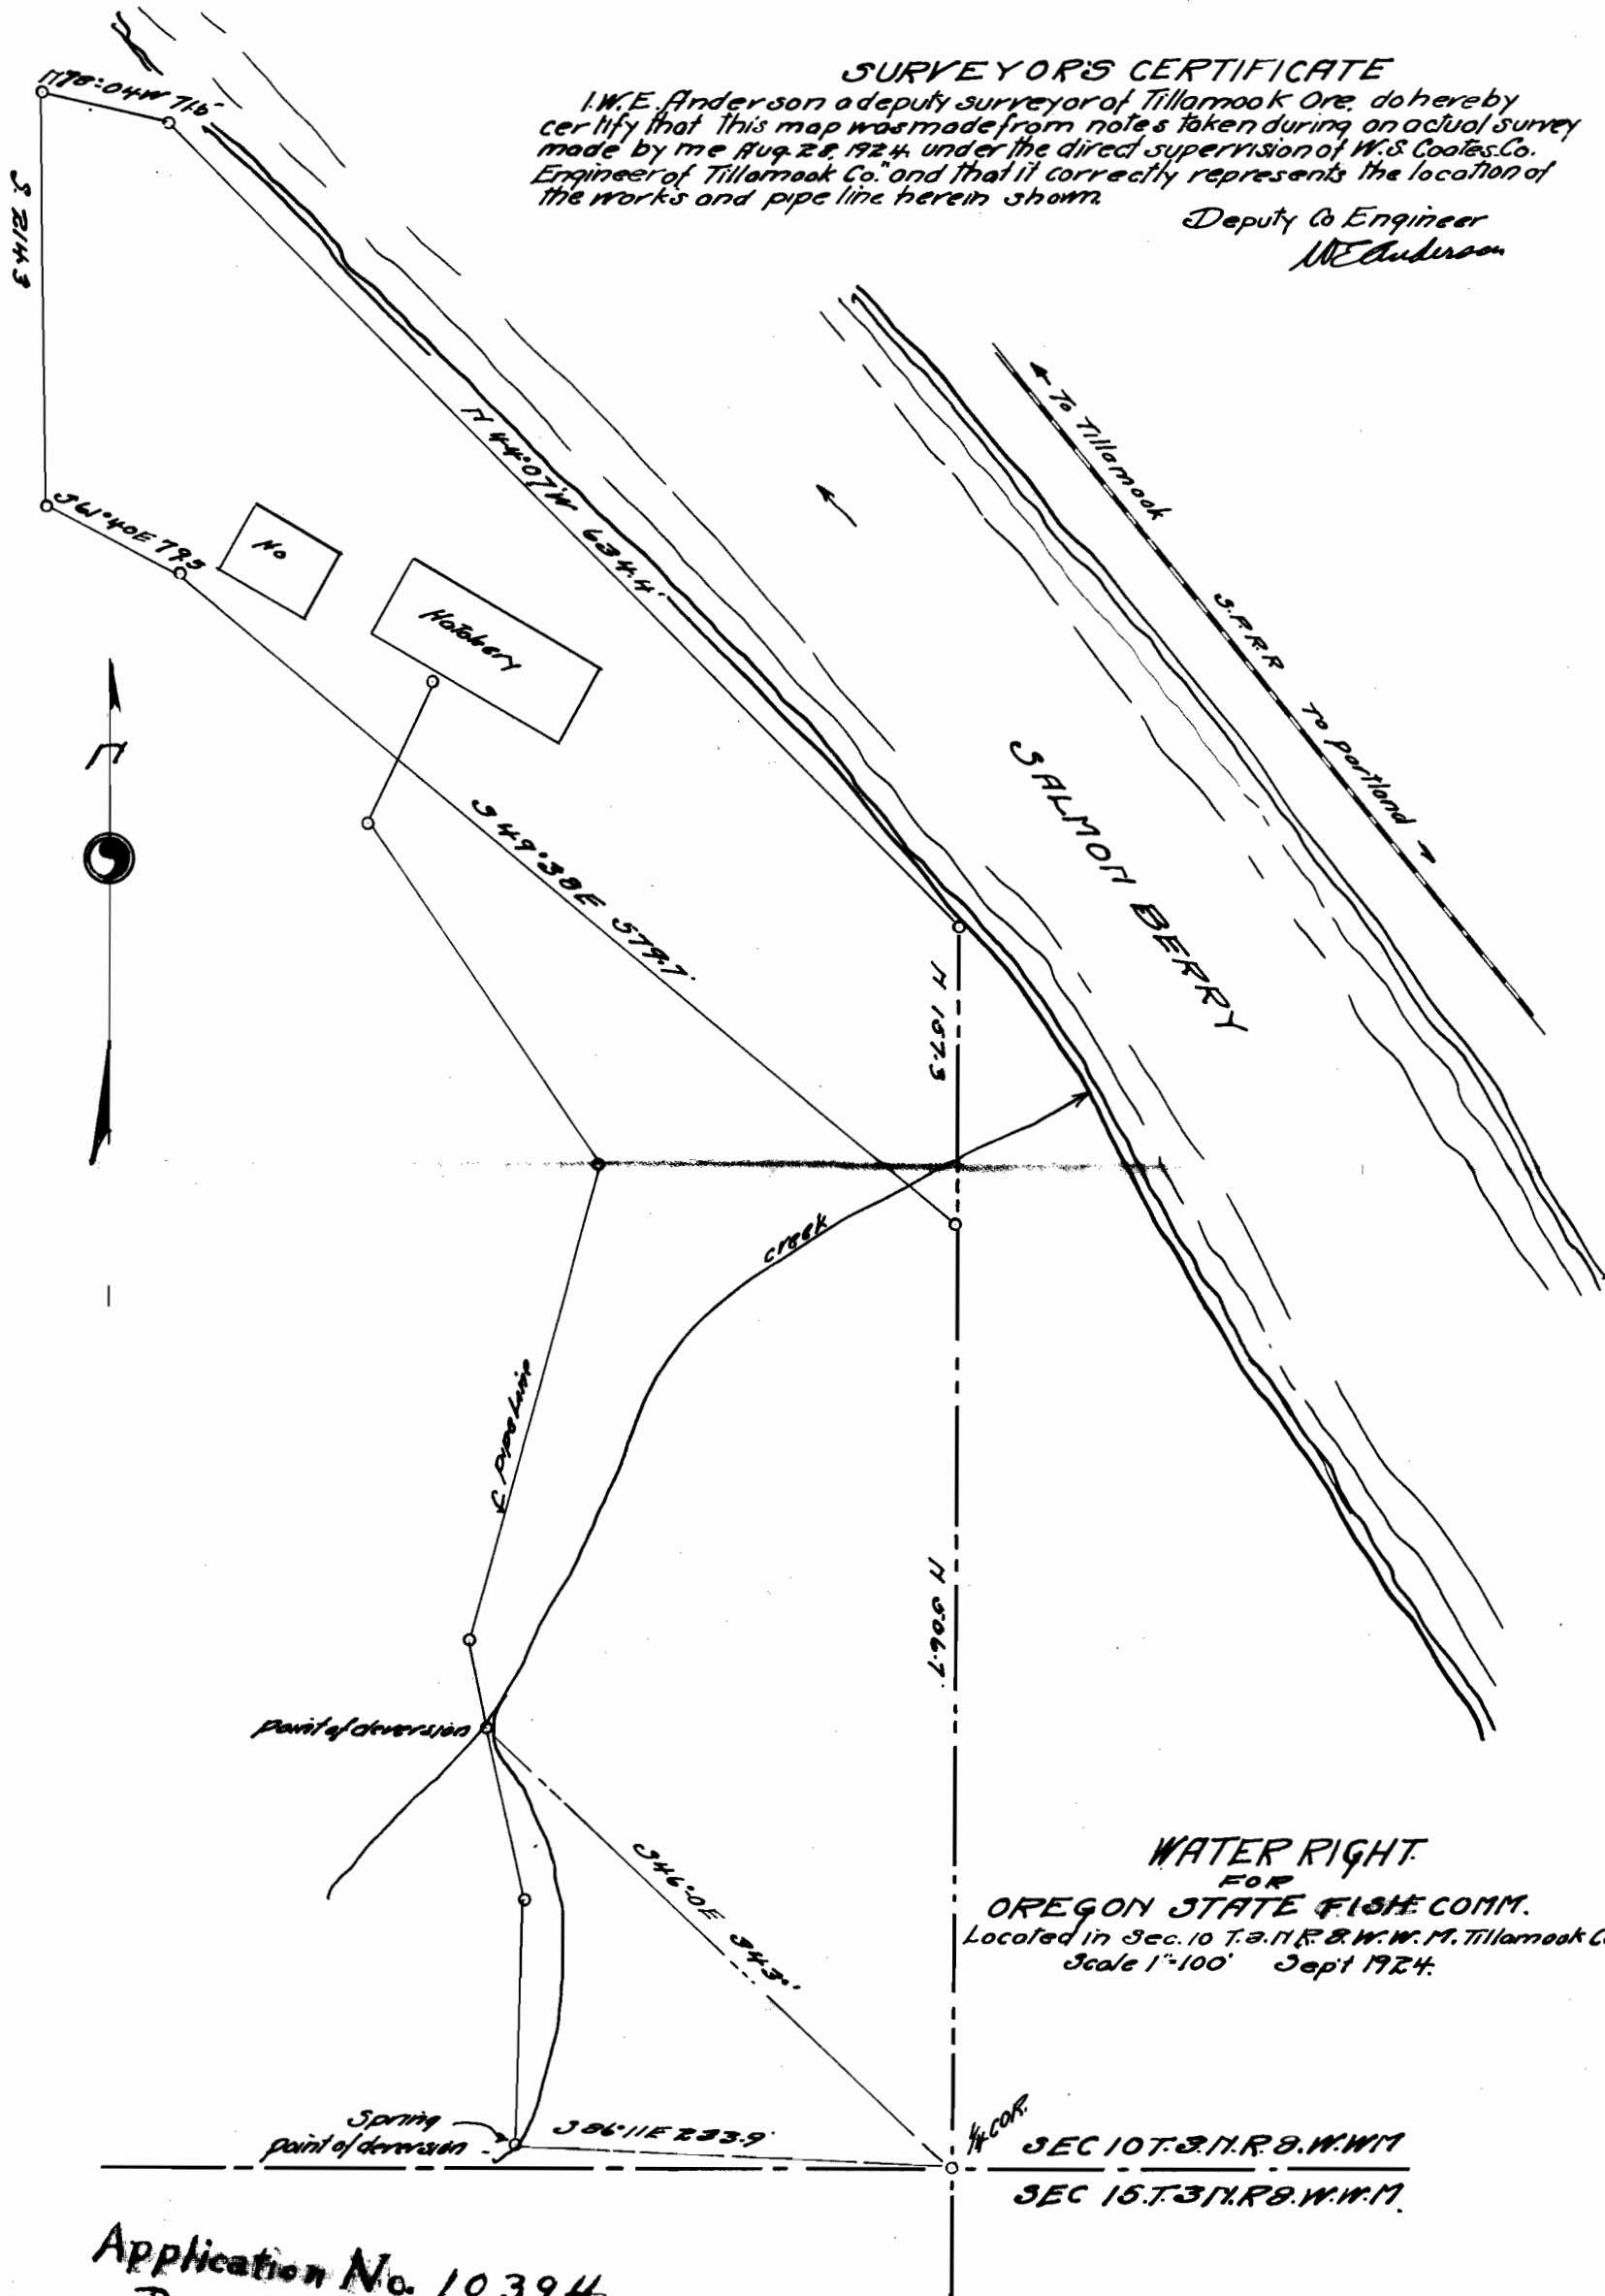

WATER RIGHT
FOR
OREGON STATE FISH COMM.
Located in Sec. 10 T. 2. N. R. 8. W. W. M. Tillamook Co.
Scale 1"=100' Sept 1924.

1/4 COR.
SEC 10. T. 2. N. R. 8. W. W. M.
SEC 15. T. 3. N. R. 8. W. W. M.

Application No. 10394
Permit No. 6922

10394