


Township 7 S, Range 4 W.

STATE ENGINEER RECEIVED

MAR 27 1925


SALEM, OREGON

10070

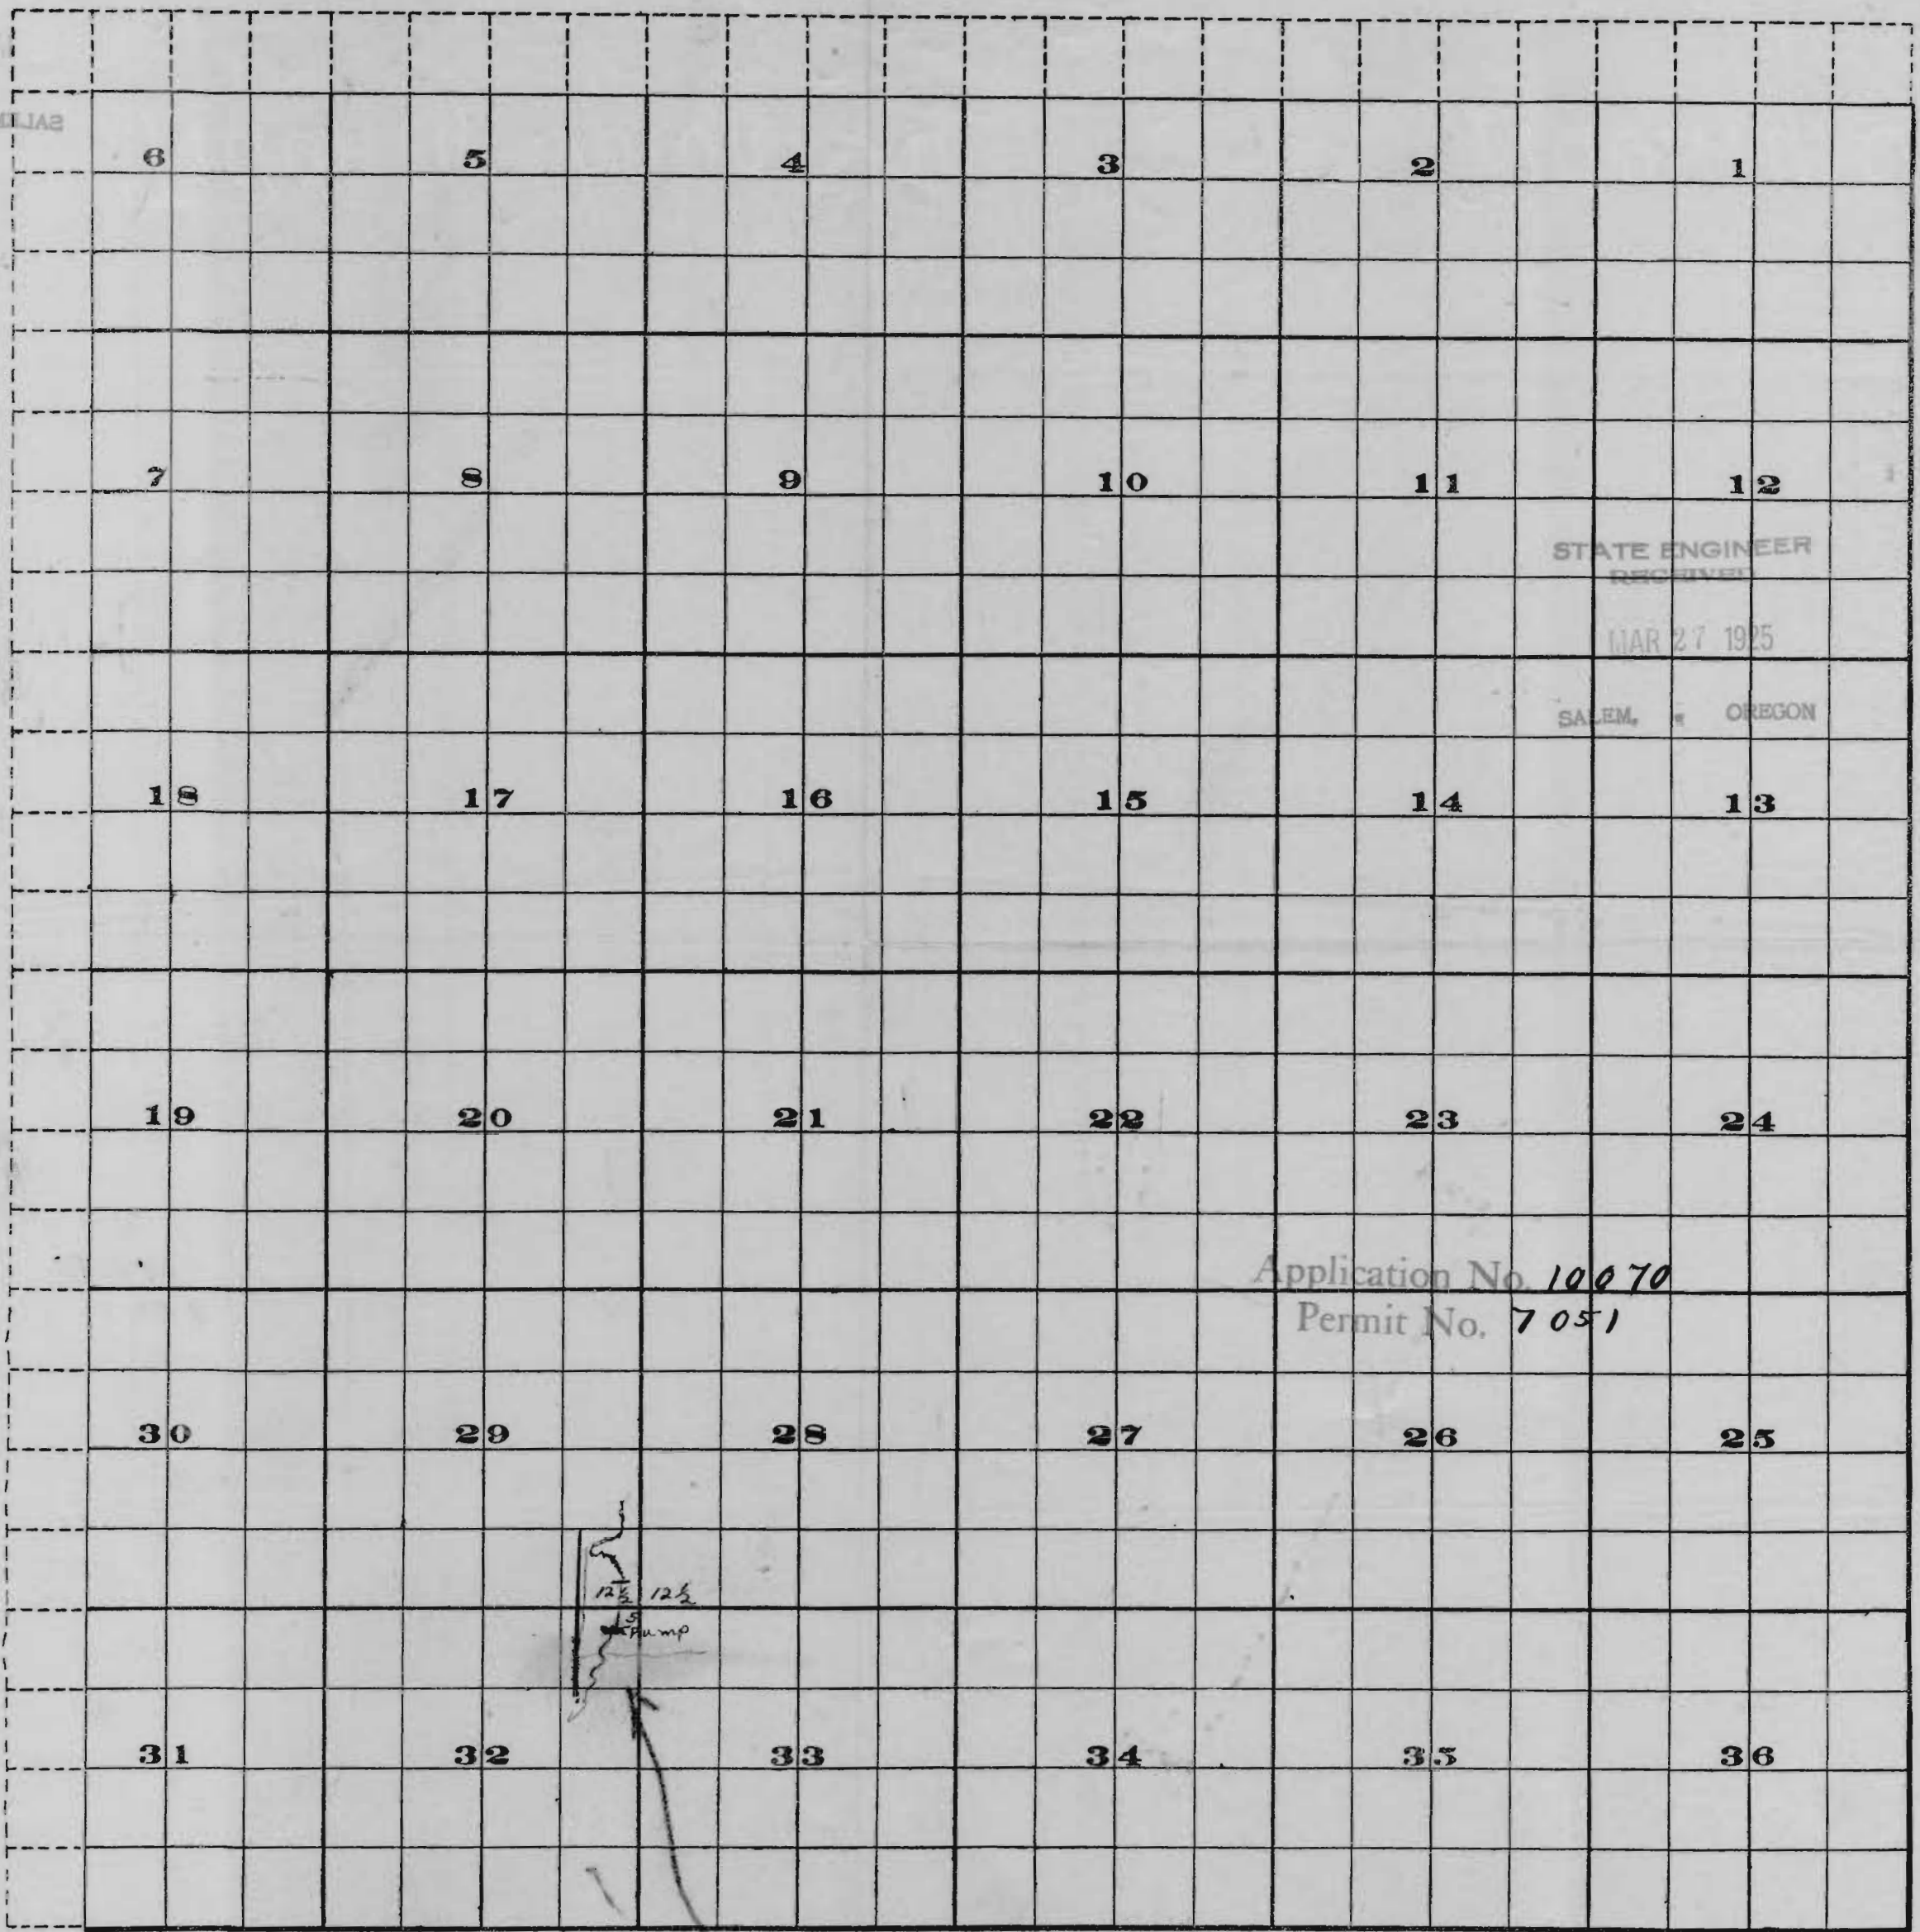

STATE ENGINEER RECEIVED
MAR 27 1925
SALEM, OREGON

Application No. 10070
Permit No. 7051

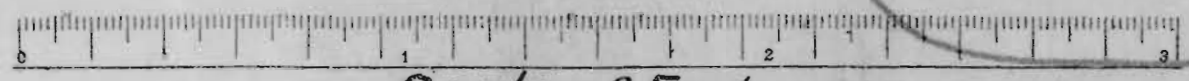

Scale of Feet.

Creek doesn't flow that direction

FROM OFFICE OF THE STATE ENGINEER, SALEM, OREGON

10070

10070

10070