


10018

Sec. 3
4
9
10
Tp. 26S
R. 3W.

STATE ENGINEER
RECEIVED
MAR 4 1925
SALEM, OREGON

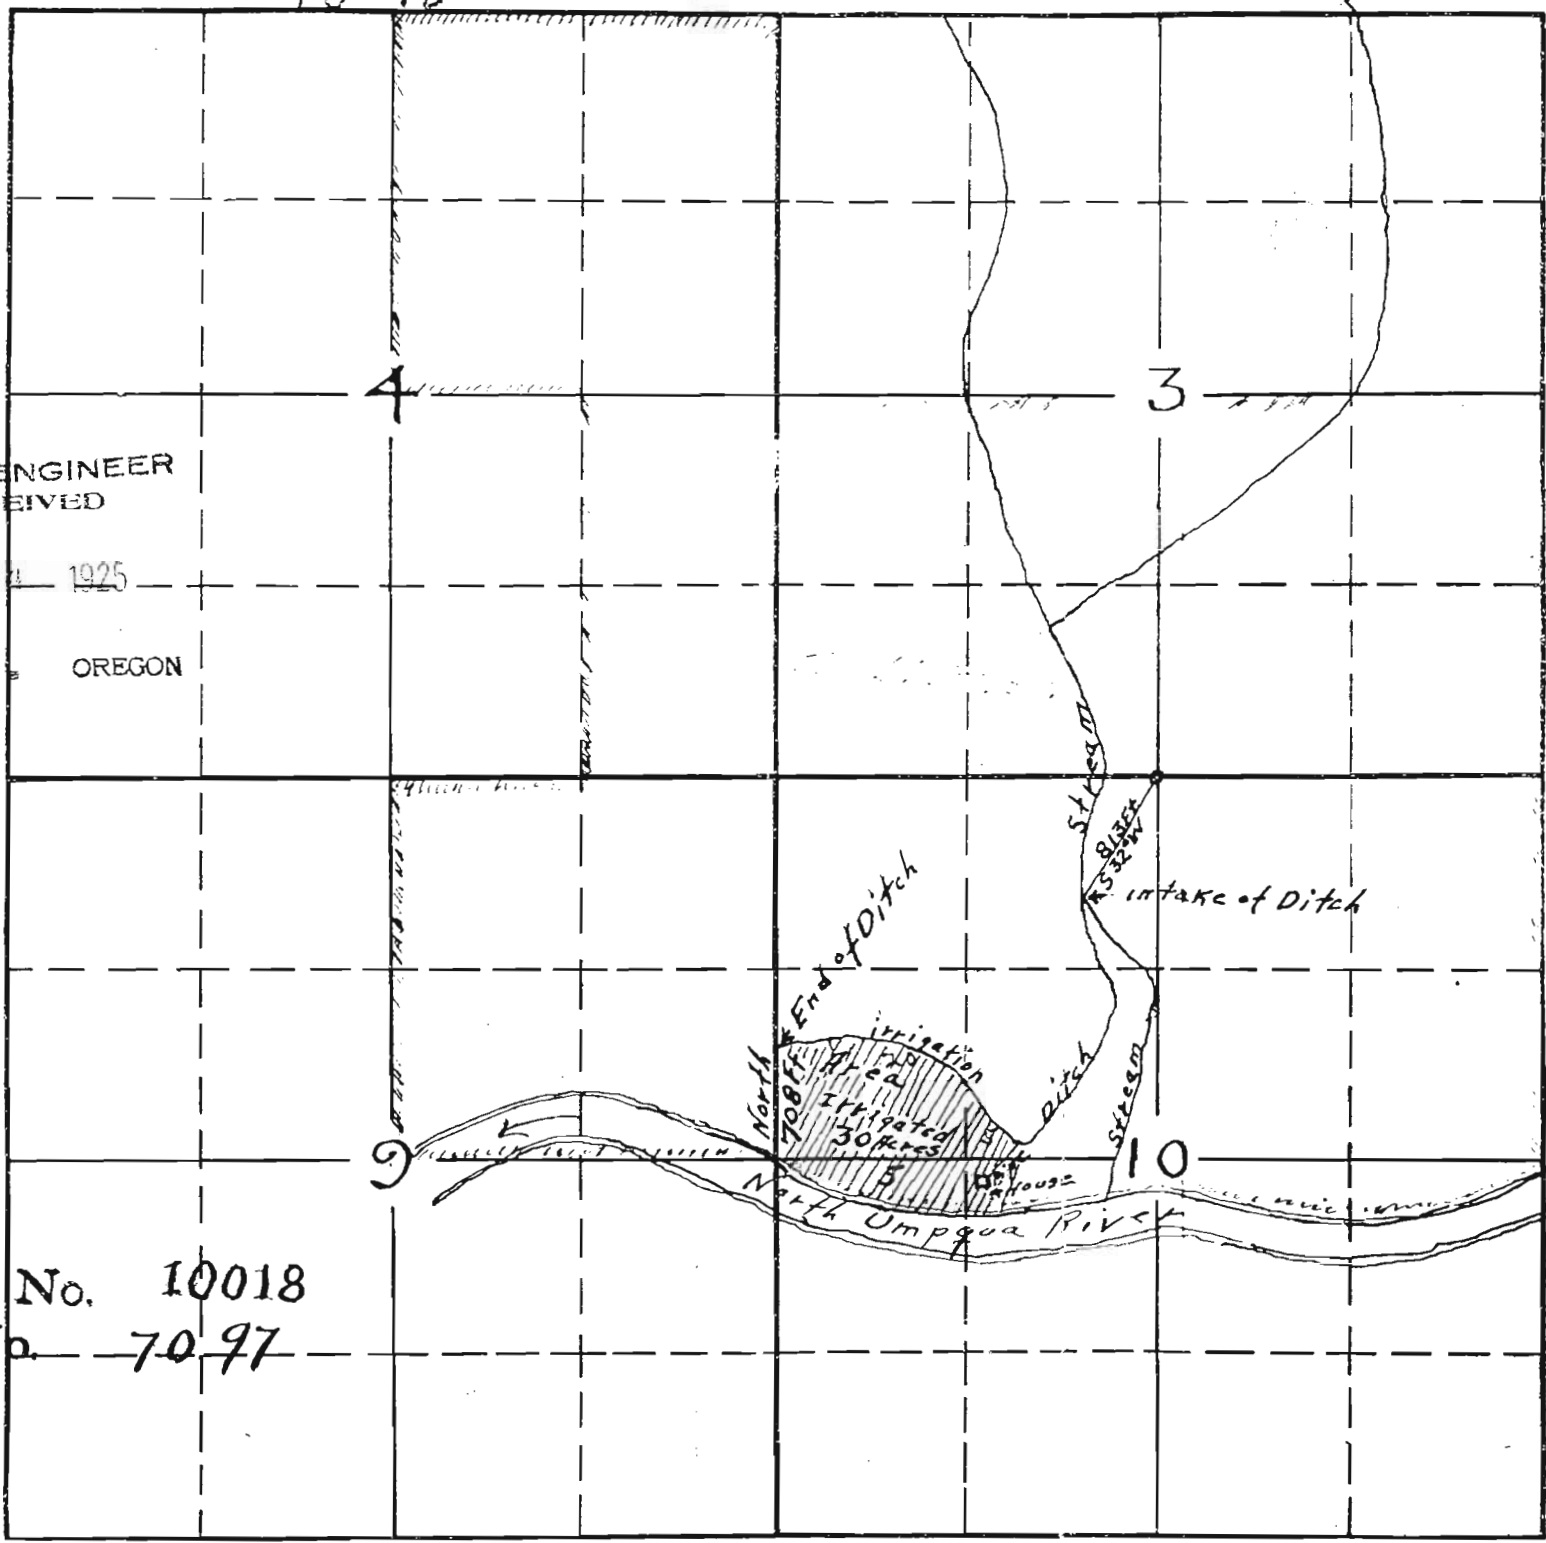

Cert 7117 describes right to the use of 0.48 cfs from unnamed stream for Dam & irrigation of:

- 20.0 ac in SW'NW'
- 5.0 ac in SE'NW'
- 5.0 ac in NE'SW'
- SEC 10

← Map shows more than 20 acres area in SW'NW', less than 5 acres in each of SE'NW' & NE'SW' and shows an area in NW¼SW¼ not covered.

Can-not determine, from records; accurate location of lands covered by W/R. Affidavits submitted were to provide for cancelling any part that map be on Lots 5 & 6 of subdivision.

If we wish to proceed, it may be necessary to have the Watermaster inspect and determine if any parts of the right may be valid.

Application No. 10018
Permit No. 7097