


Township 30 S.


Range 6 W.

01001

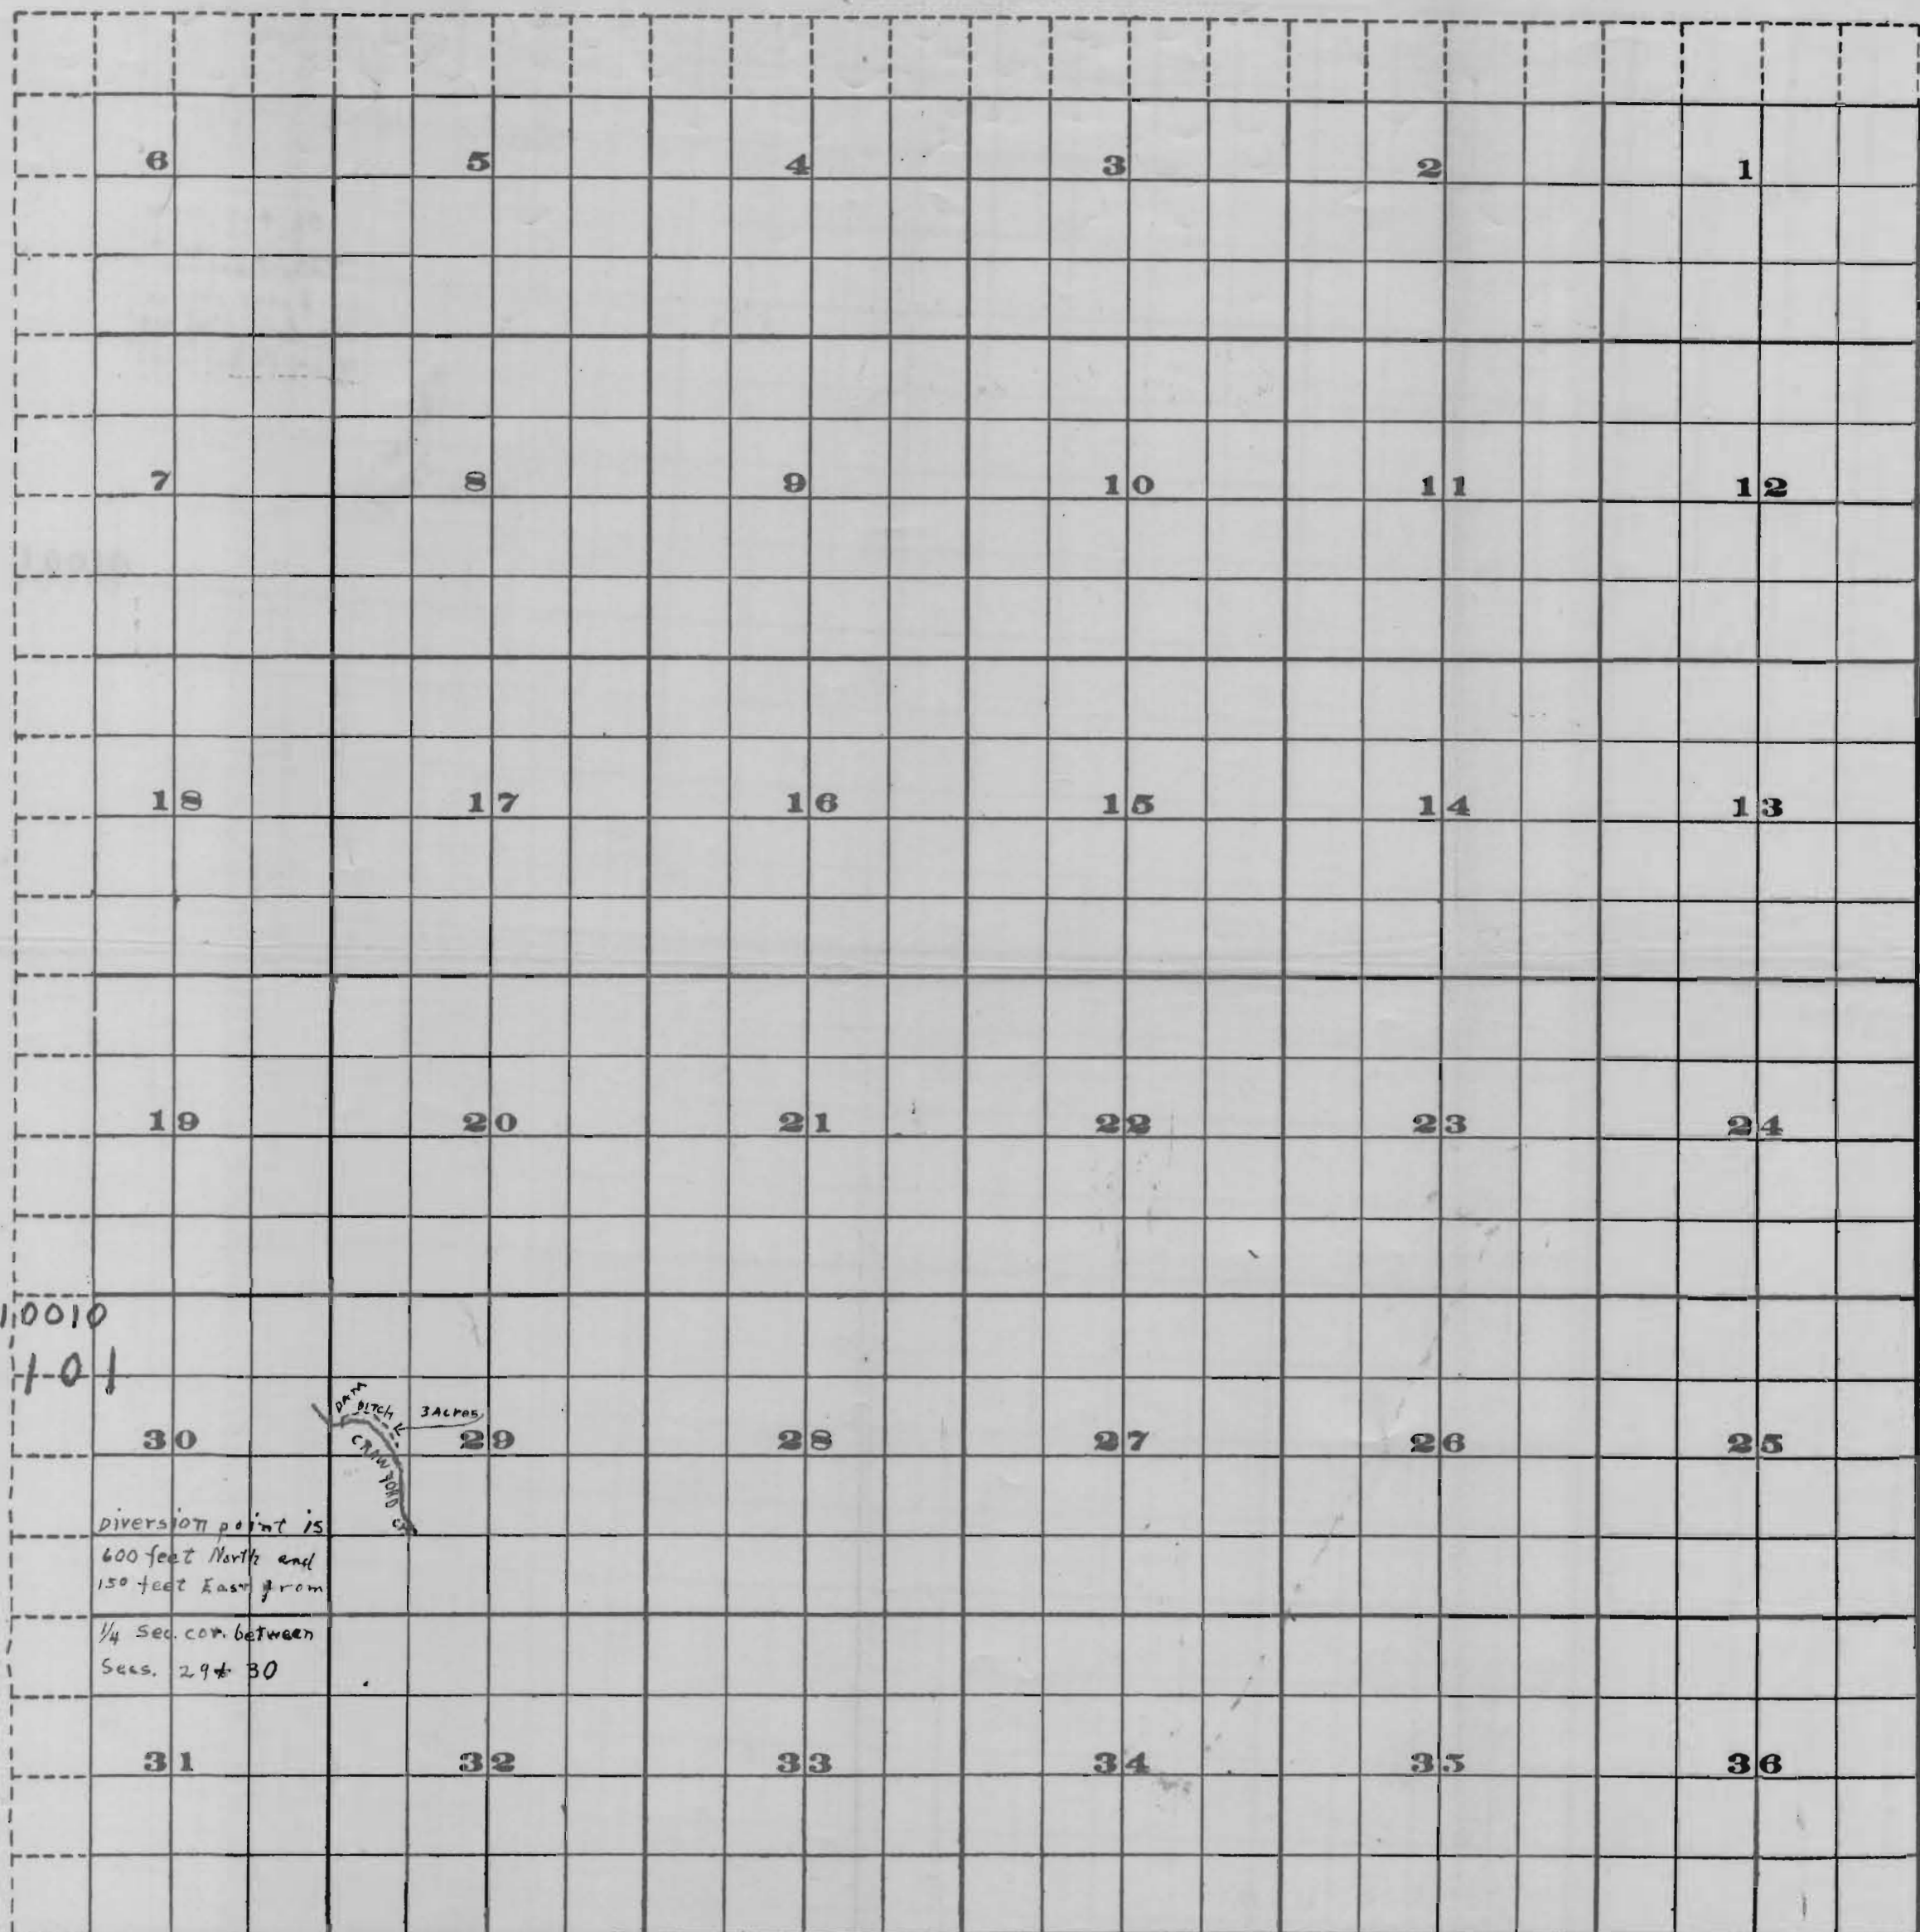

Application No. 10010
Permit No. 7101

01001

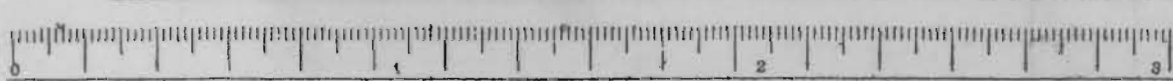

Scale of Feet.

10010