


10285

Sec. 26

Tp. 1 S.

R. 5 W.

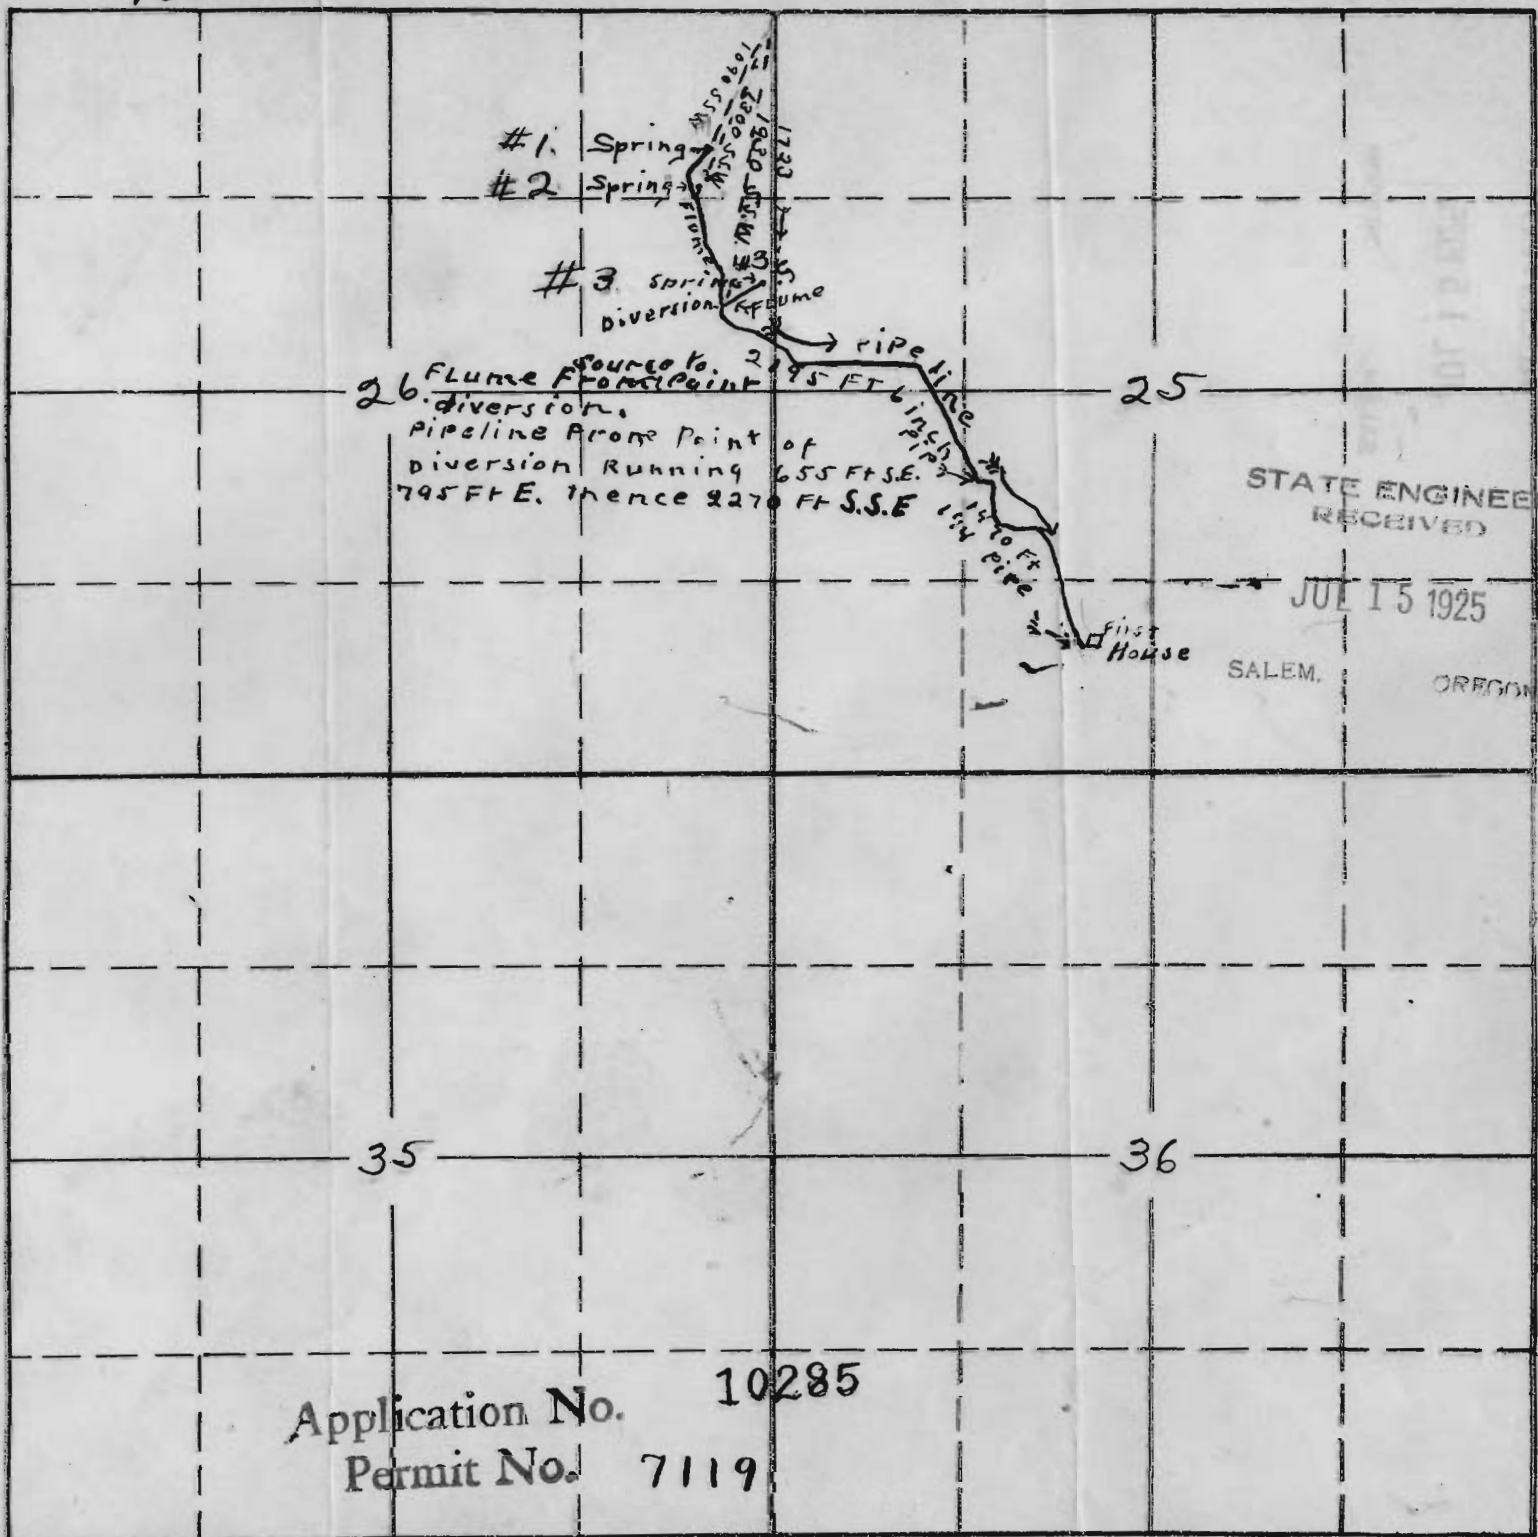

2 Sheets
sheet #1

STATE ENGINEER
RECEIVED
JUL 15 1925
SALEM, OREGON

Application No. 10285
Permit No. 7119

10285

RANGE 5 W.


RANGE 4 W.

Sec. _____
Tp. _____
R. _____

2 Sheets-
No. 2.

Township No. 1 S.

Township No. 2 S.

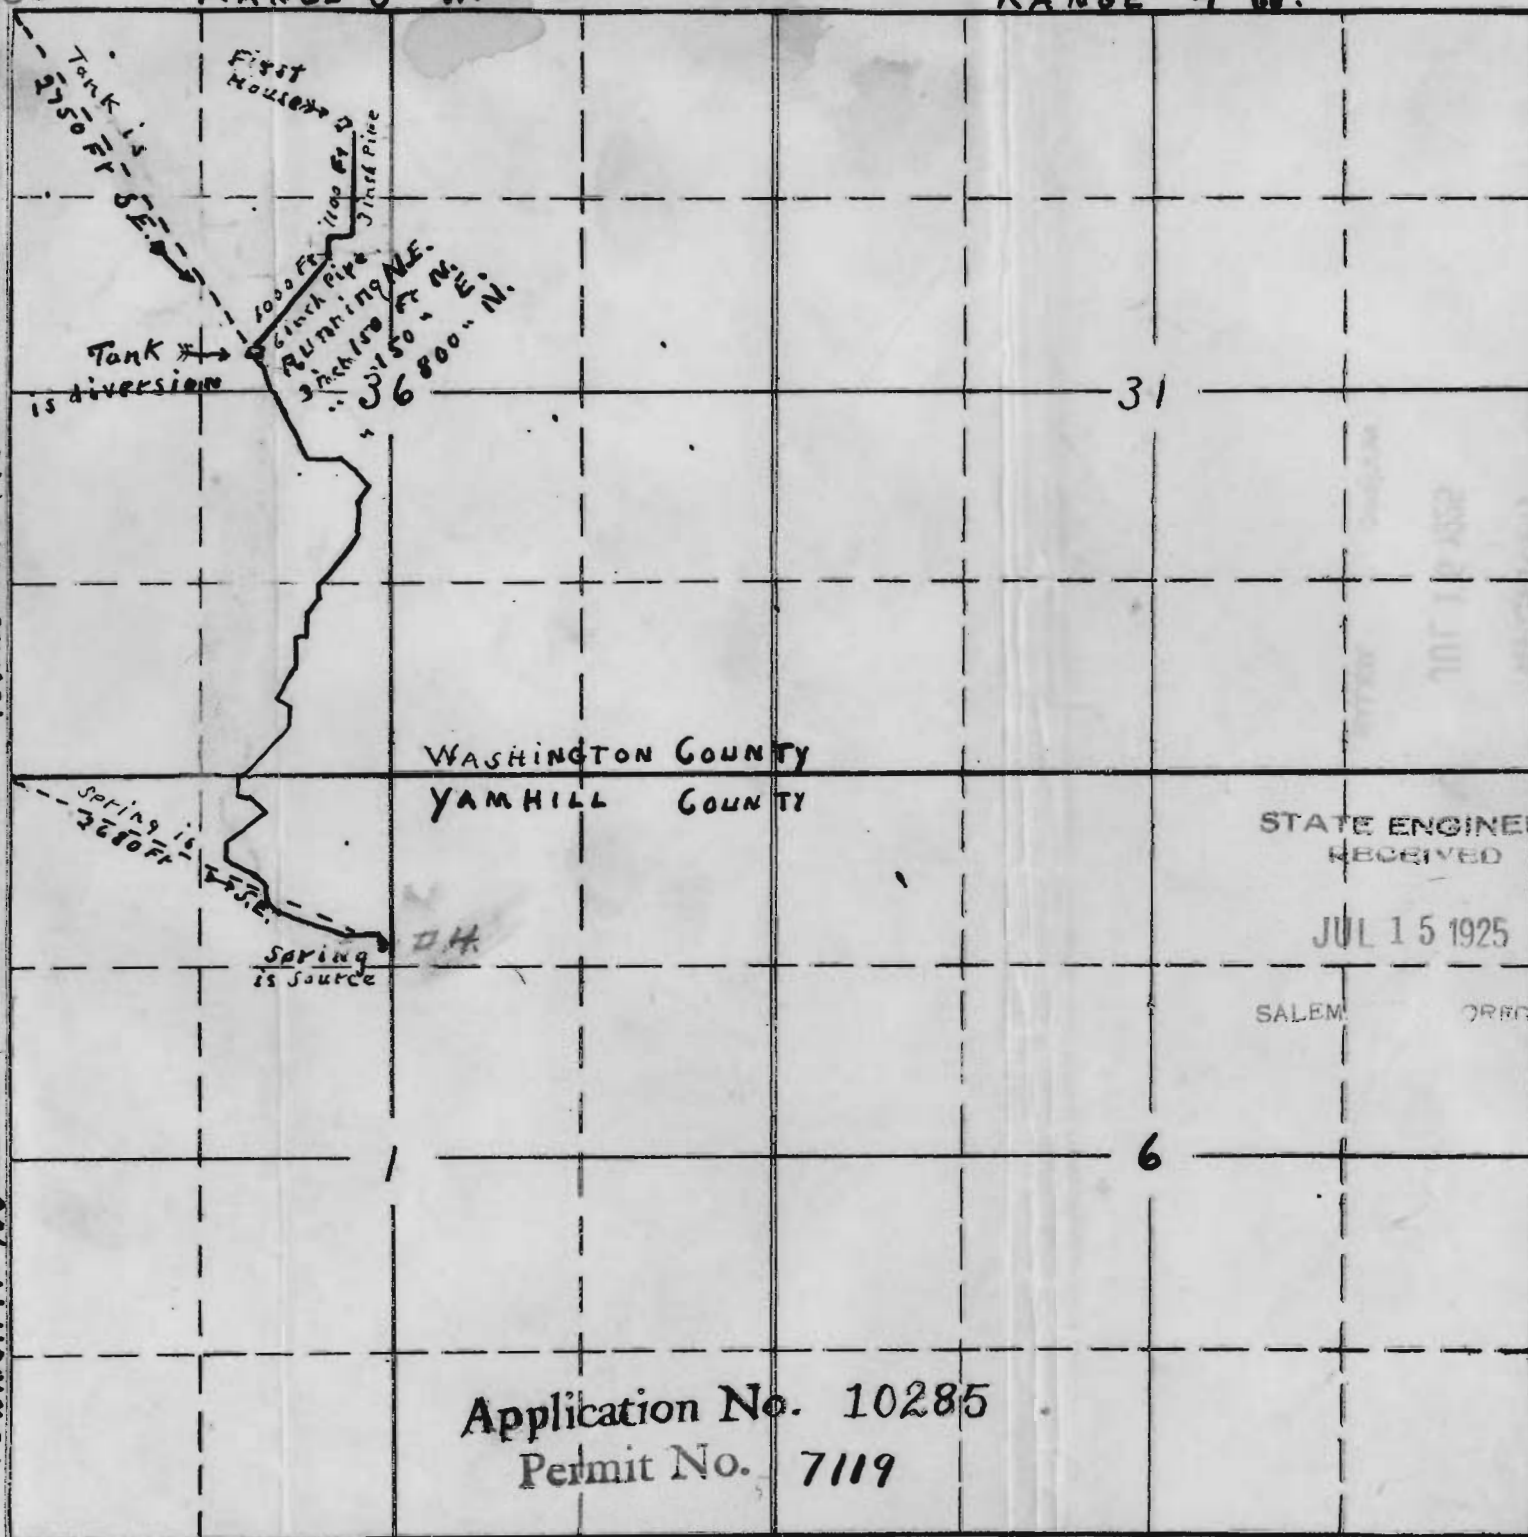

Tank is diversion

First House

1000 Ft. Black Pipe
1100 Ft. 3 Inch Pipe
1100 Ft. 3 Inch Pipe
2750 Ft. S.E.
6800' N.

Spring is source

WASHINGTON COUNTY
YAMHILL COUNTY

31

STATE ENGINEER
RECEIVED

JUL 15 1925

SALEM OREGON



6

Application No. 10285
Permit No. 7119