


MAP TO ACCOMPANY
WATER APPLICATION
OF
N. A. Humphrey
Pendleton - Oregon.

Tp. 2 N. R. 33 E.

STATE ENGINEER
RECEIVED

FEB 24 1926

SALEM, OREGON

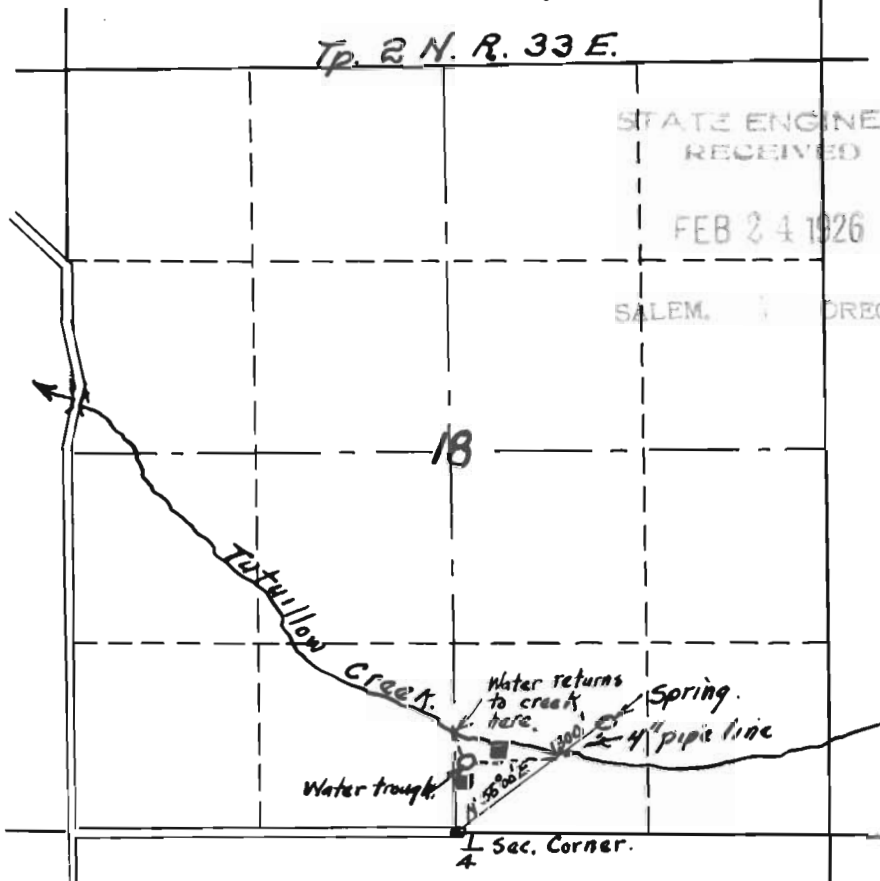

Application No. 10606
Permit No. 7209