


— MAP —

Accompanying application of W. G. MESSAL of Lake Creek
Jackson County, Oregon, for permit to the waters of
Salt Creek, and Spring tributary to Salt Creek, Jackson
County, Oregon, for Domestic and Irrigation purposes

— February 1926. —

TP 36. S. R. 2 E. W. M.

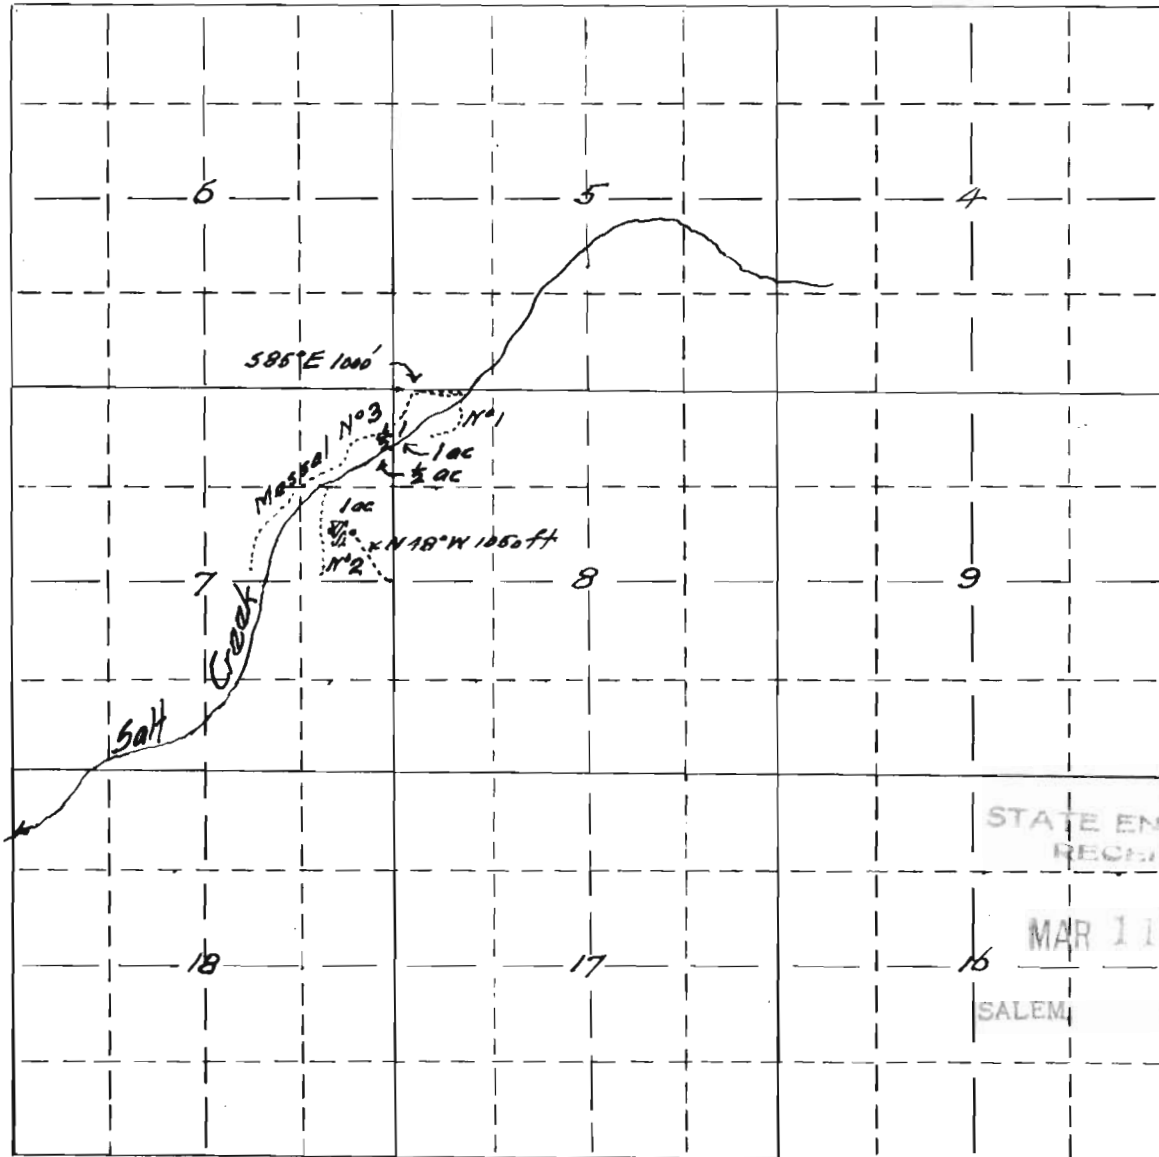

Map made from plats of Little Butte water survey
correctly showing location of lands to be irrigated
location of Spring, together with streams and ditches
in immediate vicinity. compiled by.

Application No. 10634
Permit No. 7225

— Fred. N. Cummings. C.E. —


MAP

Accompanying final proof on application No 10634 in the name of W. G. Messal of Lake Creek, Jackson County Ore. to the waters of Salt Creek and unnamed Spring trib to Little Butte Creek Jackson Co. Oregon

- Dec. - 1929 -

Township 36 S. Range 2 E.

6 5
7 8

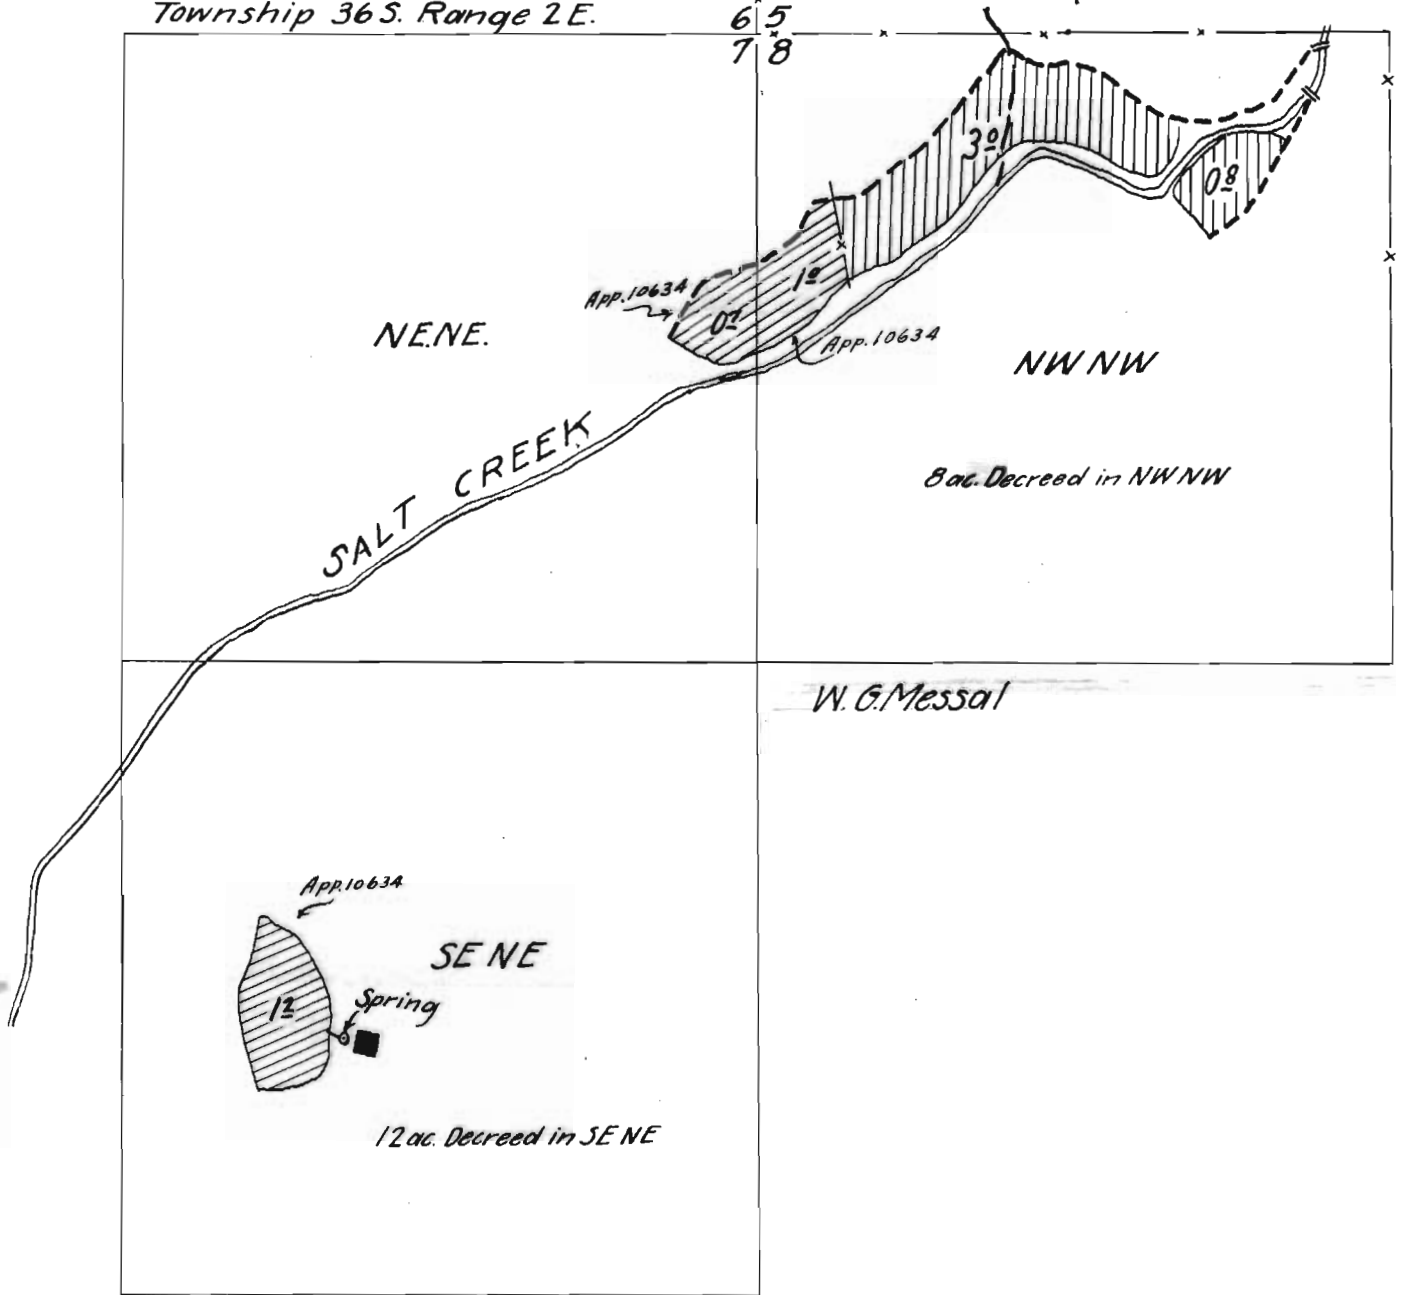

Map made from survey by the Water Masters office correctly showing lands irrigated and location of spring together with streams and ditches in the immediate vicinity

Chester A. Cummings Asst Water Master

10634