

Loan No. _____

OregonLife Insurance Company

Name of Applicant J. F. Binford - Water Filing

Section 25 Township No. 6 N Range No. 34 E.M.M.

Tp. 6 N 34 E

NORTH

Tp. 6 N 35 E


13

18

Tp. Line

24

19

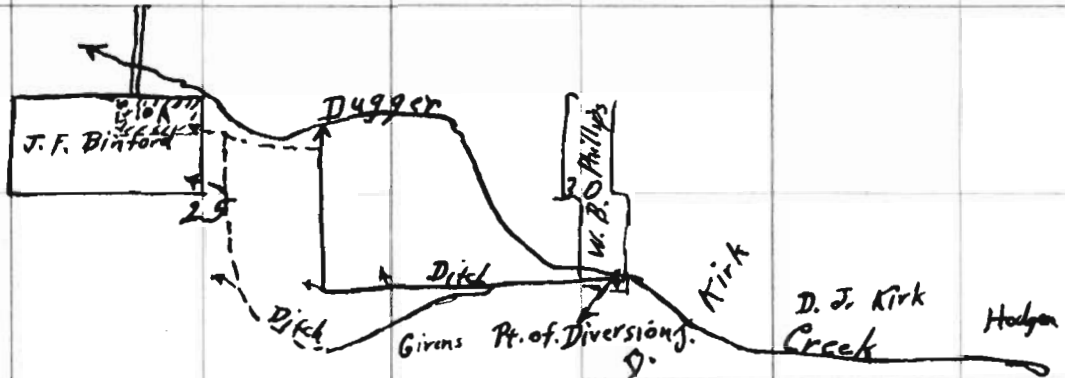

STATE ENGINEER
RECEIVED

APR 8 1926

36

31

SALEM, OREGON

SOUTH

NOTE:—Draw outline of your property on the above plat as nearly correct as you can and show location of buildings, roads, creeks, wells, ditches, etc. Give such other information as may be useful to the Appraiser.

The above plat represents one full section of land. Each small square represents 2½ acres. If the area is more than a full section let one-fourth of the plat represent a section. In the latter case one small square will represent 10 acres.

Remarks _____

Application No. 10702

Permit No. 7271