


STATE ENGINEER
RECEIVED

APR 17 1926

SALEM, OREGON

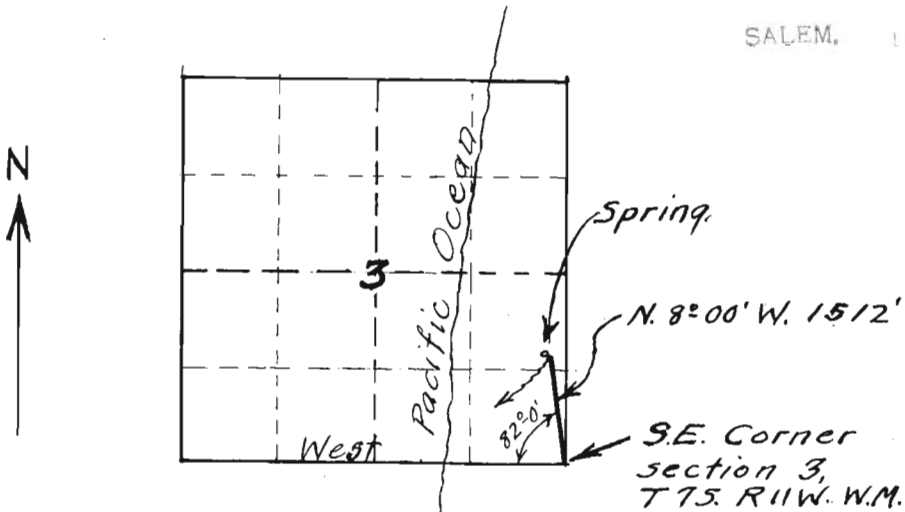

To accompany application of

Prepared by —
Beasley & Stoehr.
Portland, Ore.

2" = 1 mile

4/12/26.

Application No. 10720
Permit No. 7312