


by G.K. JENNER

Scale - 4" = 1 MI

Sec. 24

Tp. 3 S.

R. 1 E.

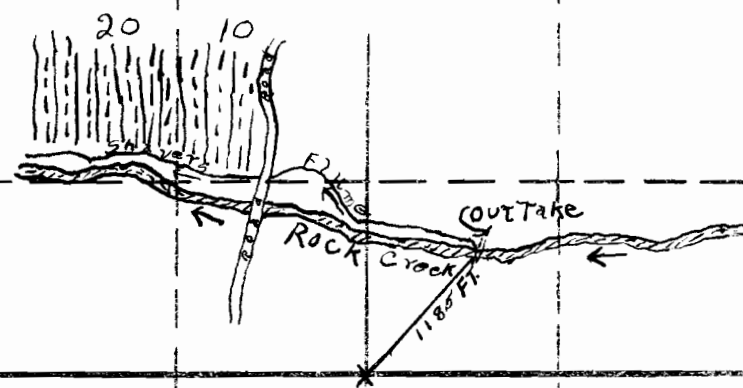

Application No. 9555  
7321