


Permit 7375

Permit: S 7375
Volume: 7
Strm: KNIGHTS G
Trib: SLATE CR
Priority: 5/22/26

01801

Emmett R. Conger
Scale 2"=1 Mile May 1926
T. 37 S., R. 7 W., W. M.

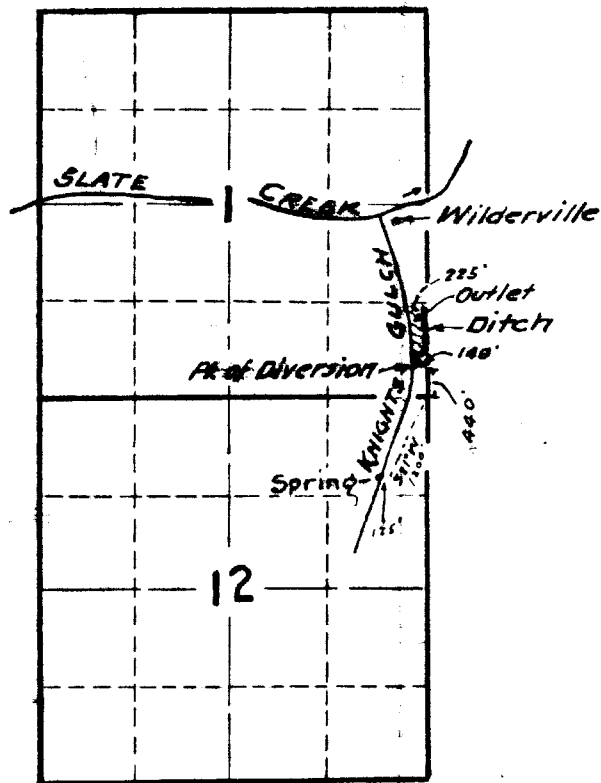

Application No. 10810
Permit No. 7375