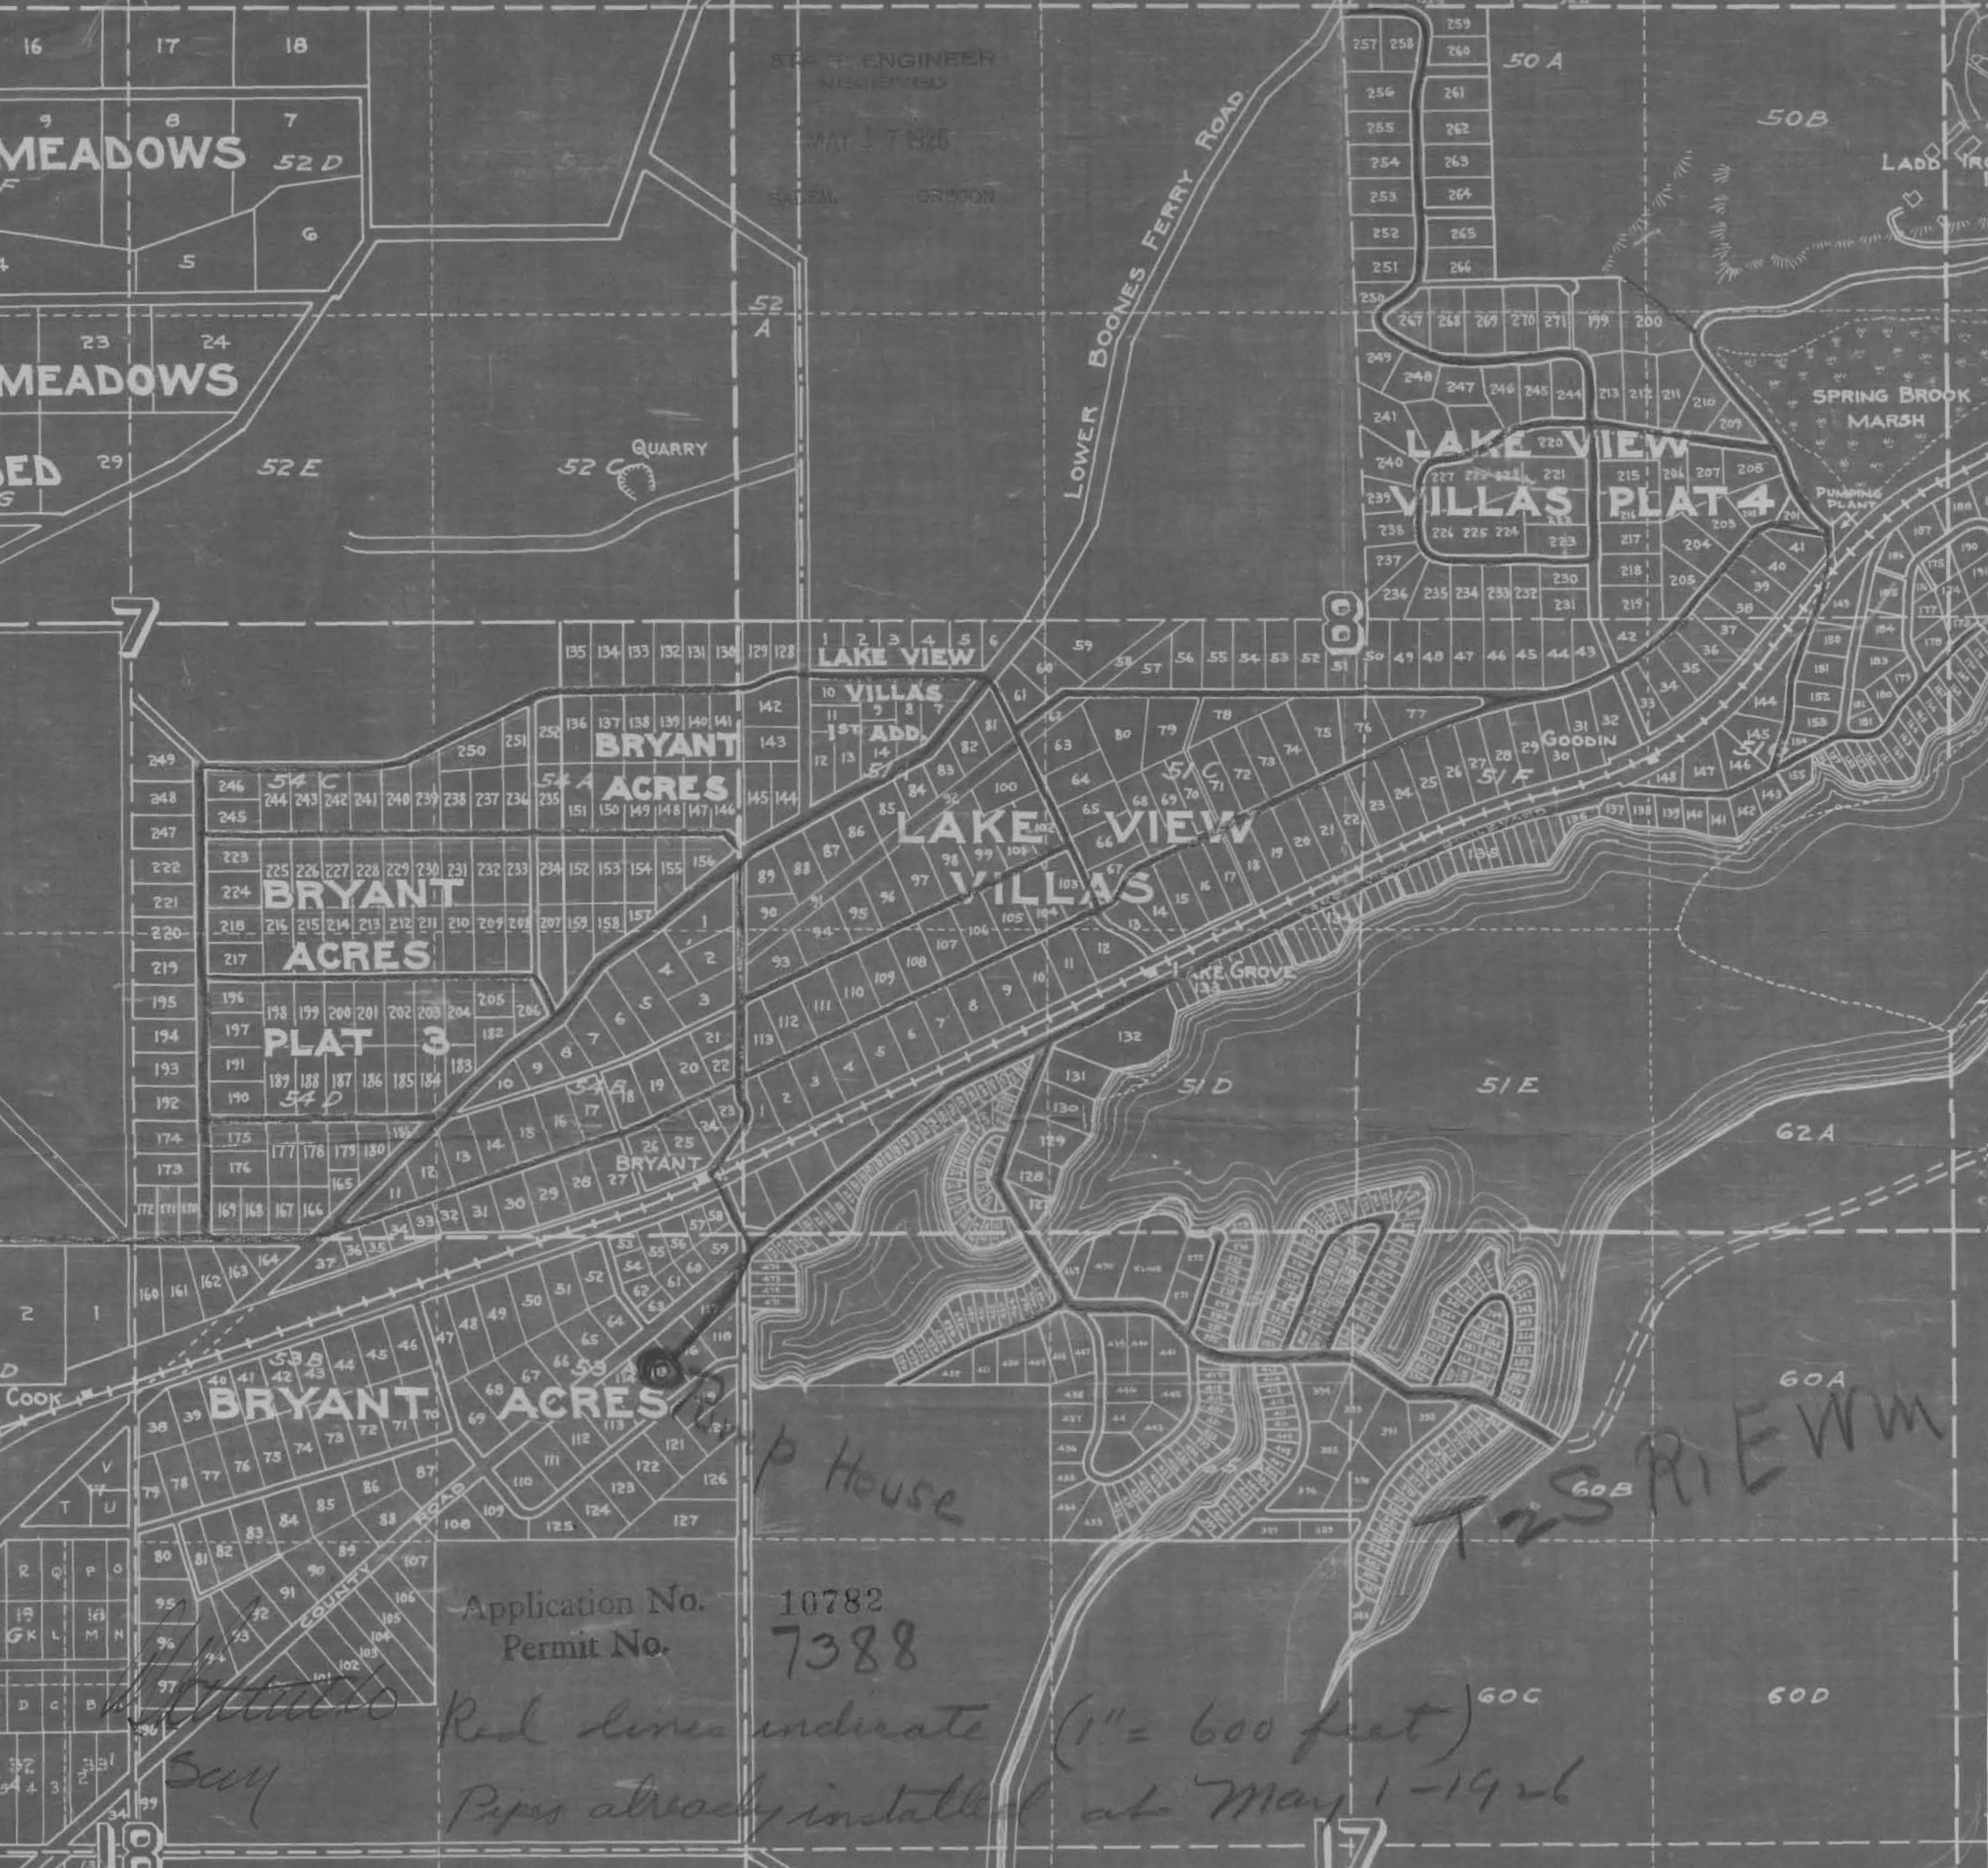

Application No. 10782
Permit No. 7388

Red lines indicate (1" = 600 feet)
Pipes already installed at May 1-1926

STATE ENGINEER
RECEIVED
MAY 17 1926
SALEM OREGON
LOWER BOONES FERRY ROAD
LAKE VIEW VILLAS PLAT 4
SPRING BROOK MARSH
PUMPING PLANT
LAKE VIEW VILLAS 1ST ADD.
BRYANT ACRES
BRYANT ACRES PLAT 3
LAKE VIEW VILLAS
LAKE GROVE
GOODIN
QUARRY
DOWS
DOWS
BRYANT ACRES
COUNTY ROAD
Pump House
T2S R1E WM
Application No. 10782
Permit No. 7388
Red lines indicate (1" = 600 feet)
pipes already installed at May 1-1926