


Sec. 16
Tp. 33
R. 40E
WSM

STATE ENGINEER
RECEIVED
JUN 24 1926
SALEM. OREGON

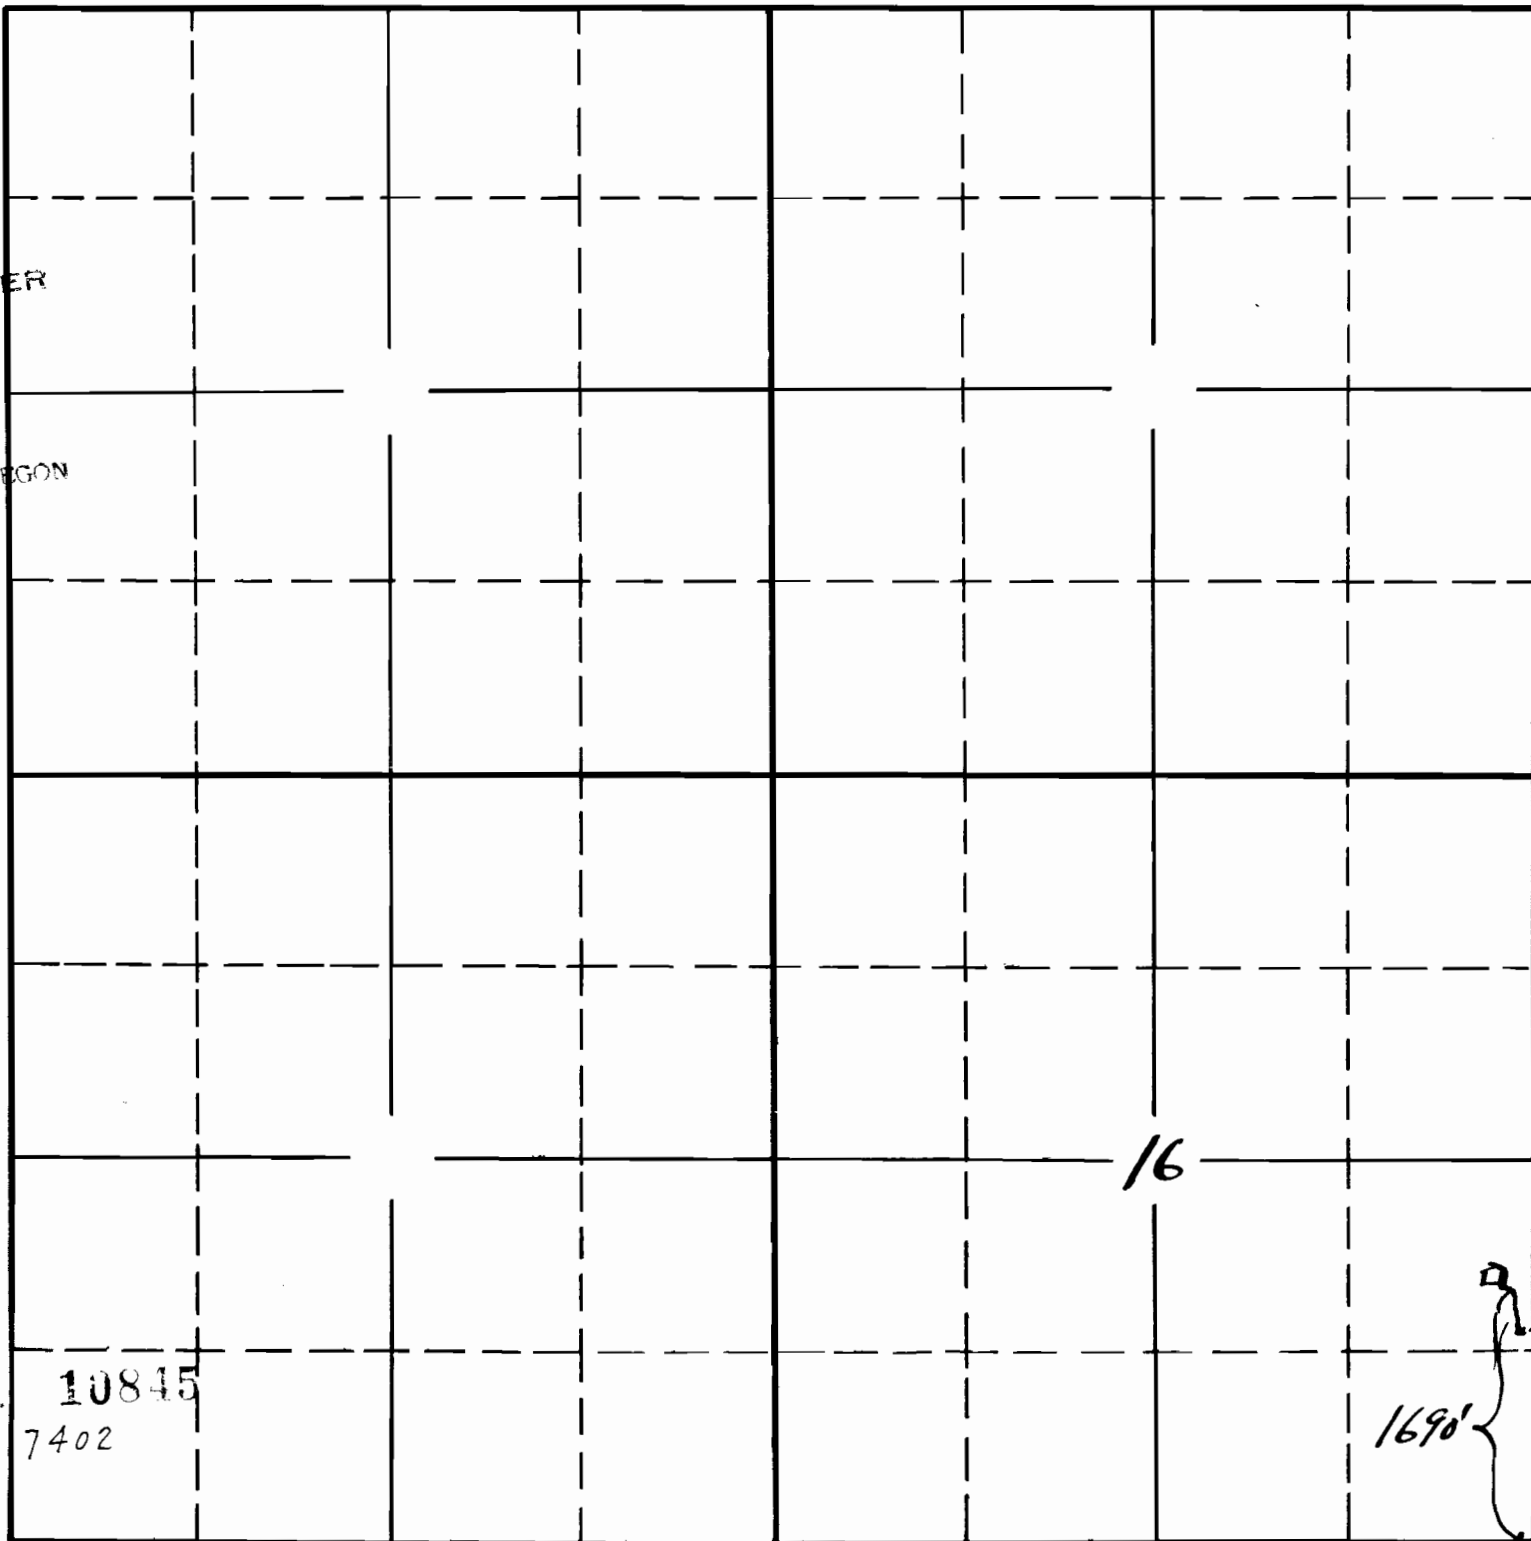

Application No. 10845
Permit No. 7402

Spring
1690'
50'