


10839

Sec. 16
17

Tp. 35 S.

R. 1 W.

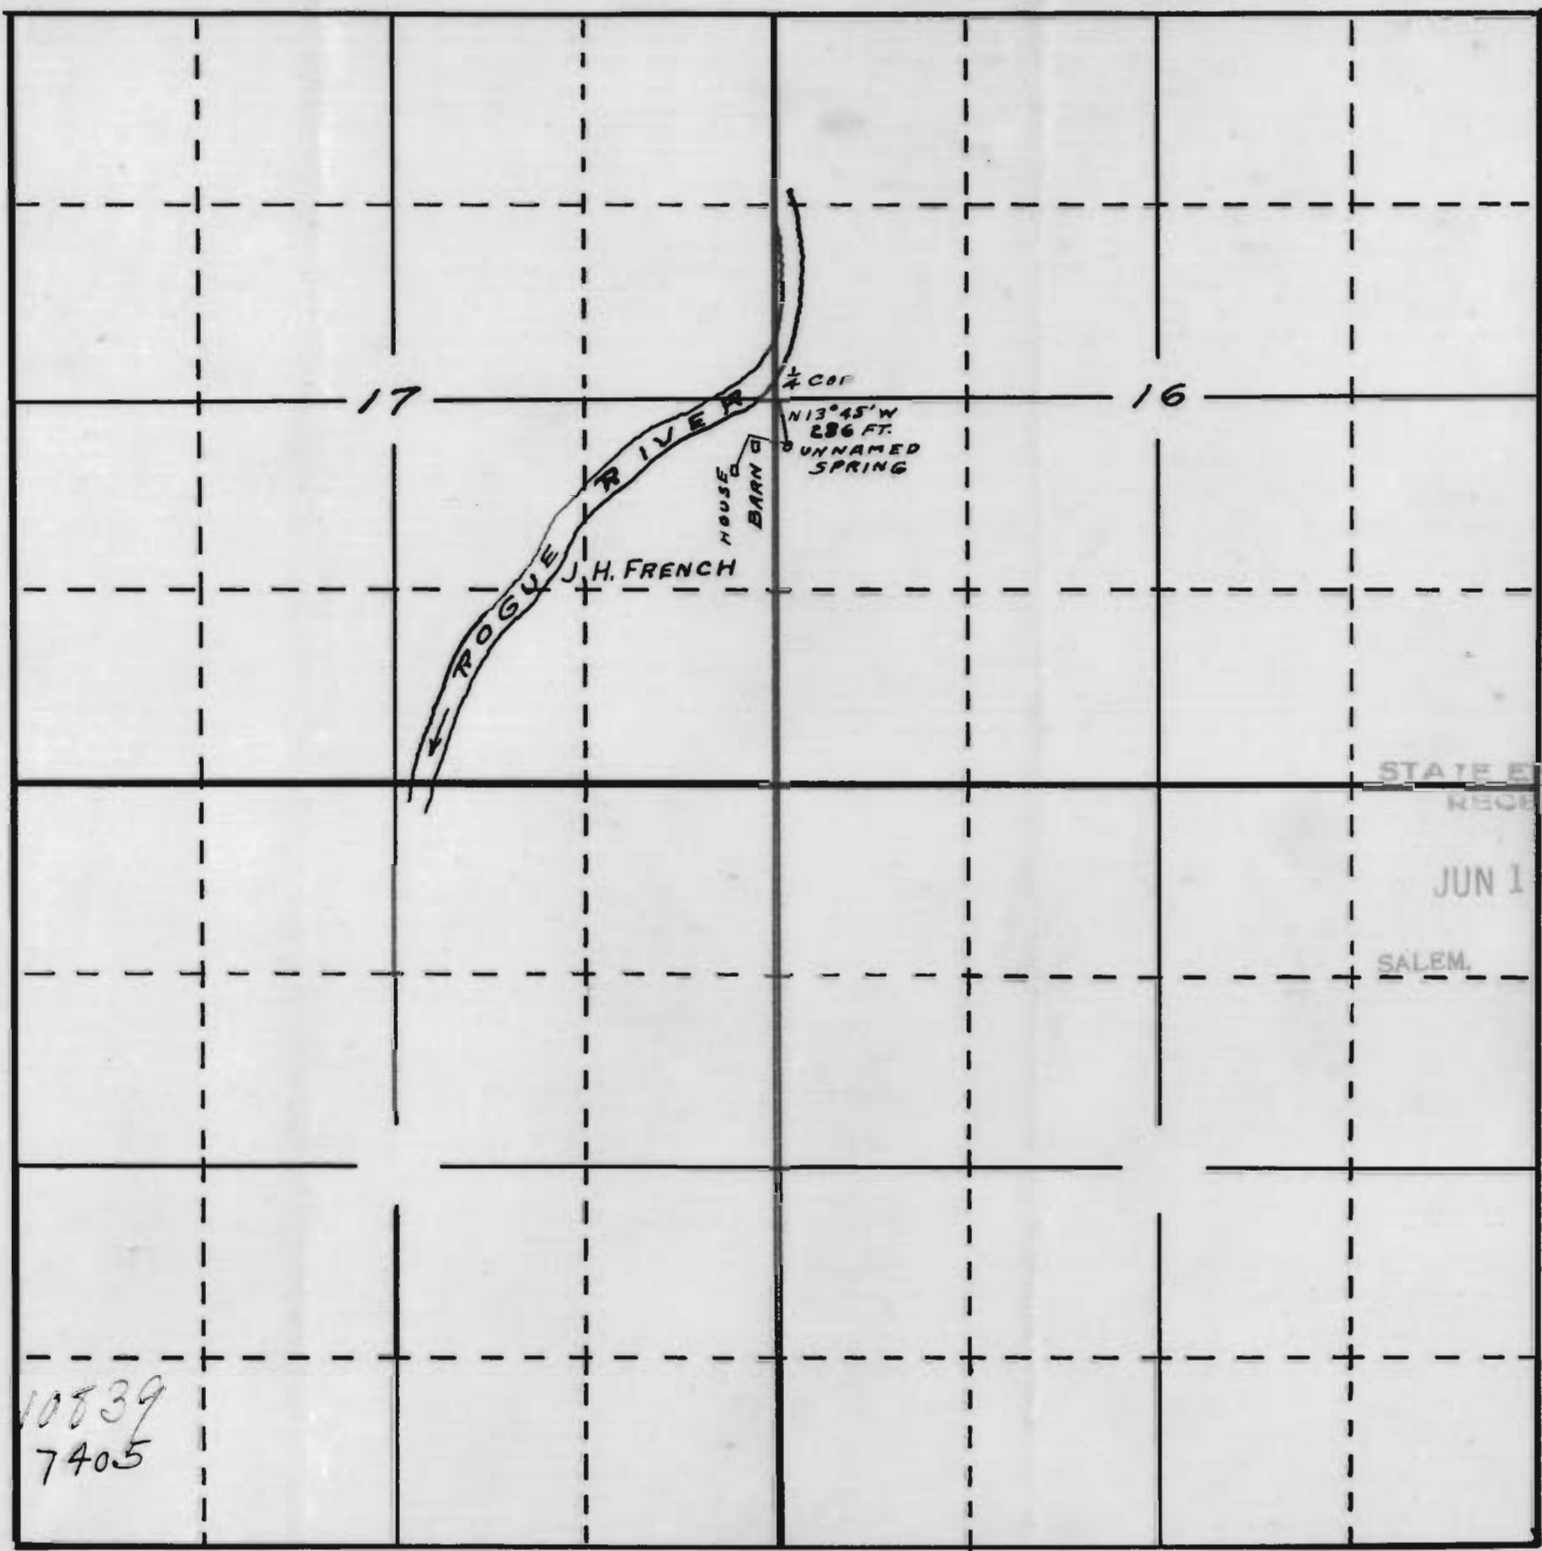

STATE ENGINEER
RECEIVED

JUN 14 1926

SALEM. OREGON

Application No.
Permit No.

10839
7405

10839