


Page 35 Lines 3-4 & 13
roads west of N.E. Cor of
S 1/4 N 1/4 W 1/4

Application #
10878
Per. No. 7443

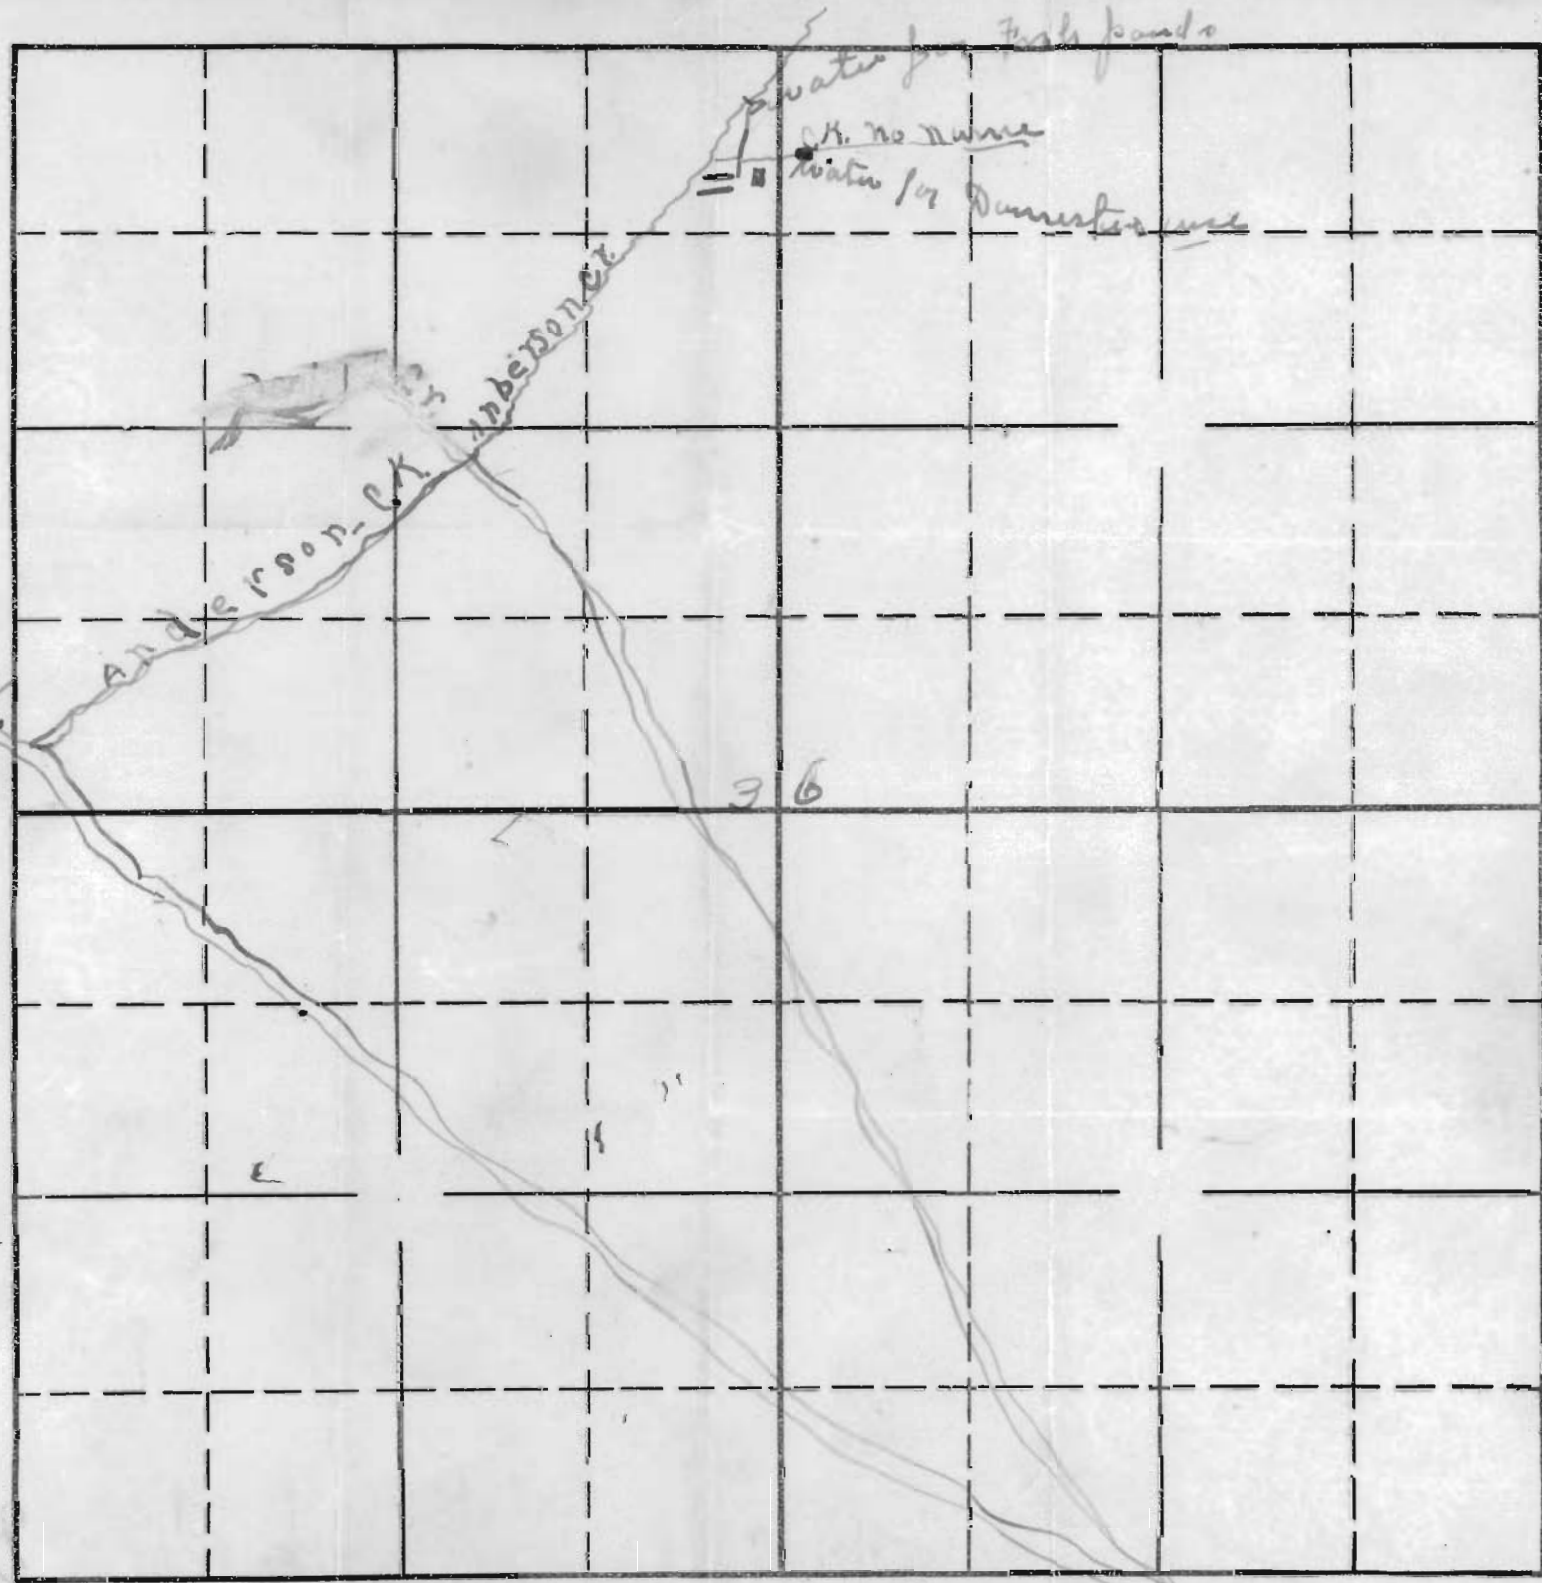

Sec. 36
7A-
Cor. of
N 2 1/4 W 1/4
Tp. 7 S-
R. 11-W

10878