

TOWNSHIP 15, RANGE 3 and 4, W. M.

North

Sketched from maps filed with water rights in State Engineer's Dept. ▴ denotes point of weir measurement on Aug 23, 1935

24

19

T.15.R.4W  
T.15.R.3W

Pipe line Cert. 8706

SPRING

North Branch

Weir #5

Weir #4

Weir #3

Weir No 2

Harris Cert 8884

Harris Cert. 8881

Westcott Cert. 8215

Stackpole Cert. 7286

Weir #1

TUALATIN RIVER

Road  
County

Buchanan Cert. 8082

Ott Cert. 10,800

Unnam'd Stream

Burkee

S.H.

South

25

30

South

APPLICATION No.

PERMIT No.

West

8

12

5

15

16

17

9

10

25

2

Sec. \_\_\_\_\_  
\_\_\_\_\_  
\_\_\_\_\_  
\_\_\_\_\_  
Tp. 1 South  
R. 3 West

STATE ENGINEER  
RECEIVED

JUL 19 1926

SALEM, OREGON

30

Application No.  
Permit No.

10906  
7450

10906  
7450  
Creek  
S  
1054

△

200 gal per day

12' - 118

20/2000/00

24/3333 - 138 per hr  
 24  
 93  
 72  
 213  
 192  
 21

23 gal per day


STATE ENGINEER RECEIVED

JUL 19 1926

SALEM. OREGON

raise 1/2" Delivery pipe 526' - 104' raise

Application No. 10906  
 Permit No. 7450

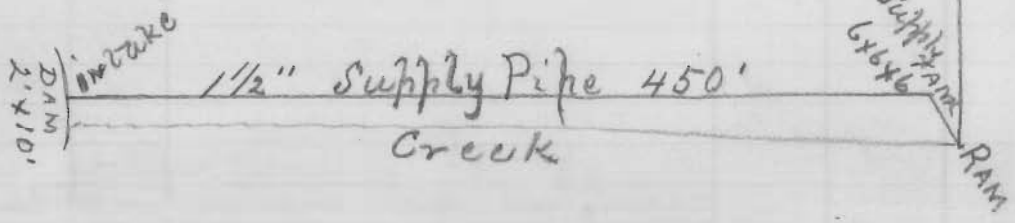

1 1/4" pipe delivers 12 gal per minute -  
 about 1/5 flow of creek -

Sw 4 of SE 1/4 Sect 30

1-2-3W

INDEX TO COMMENT