


Sec. 10

Tp. 11S.

R. 3W.

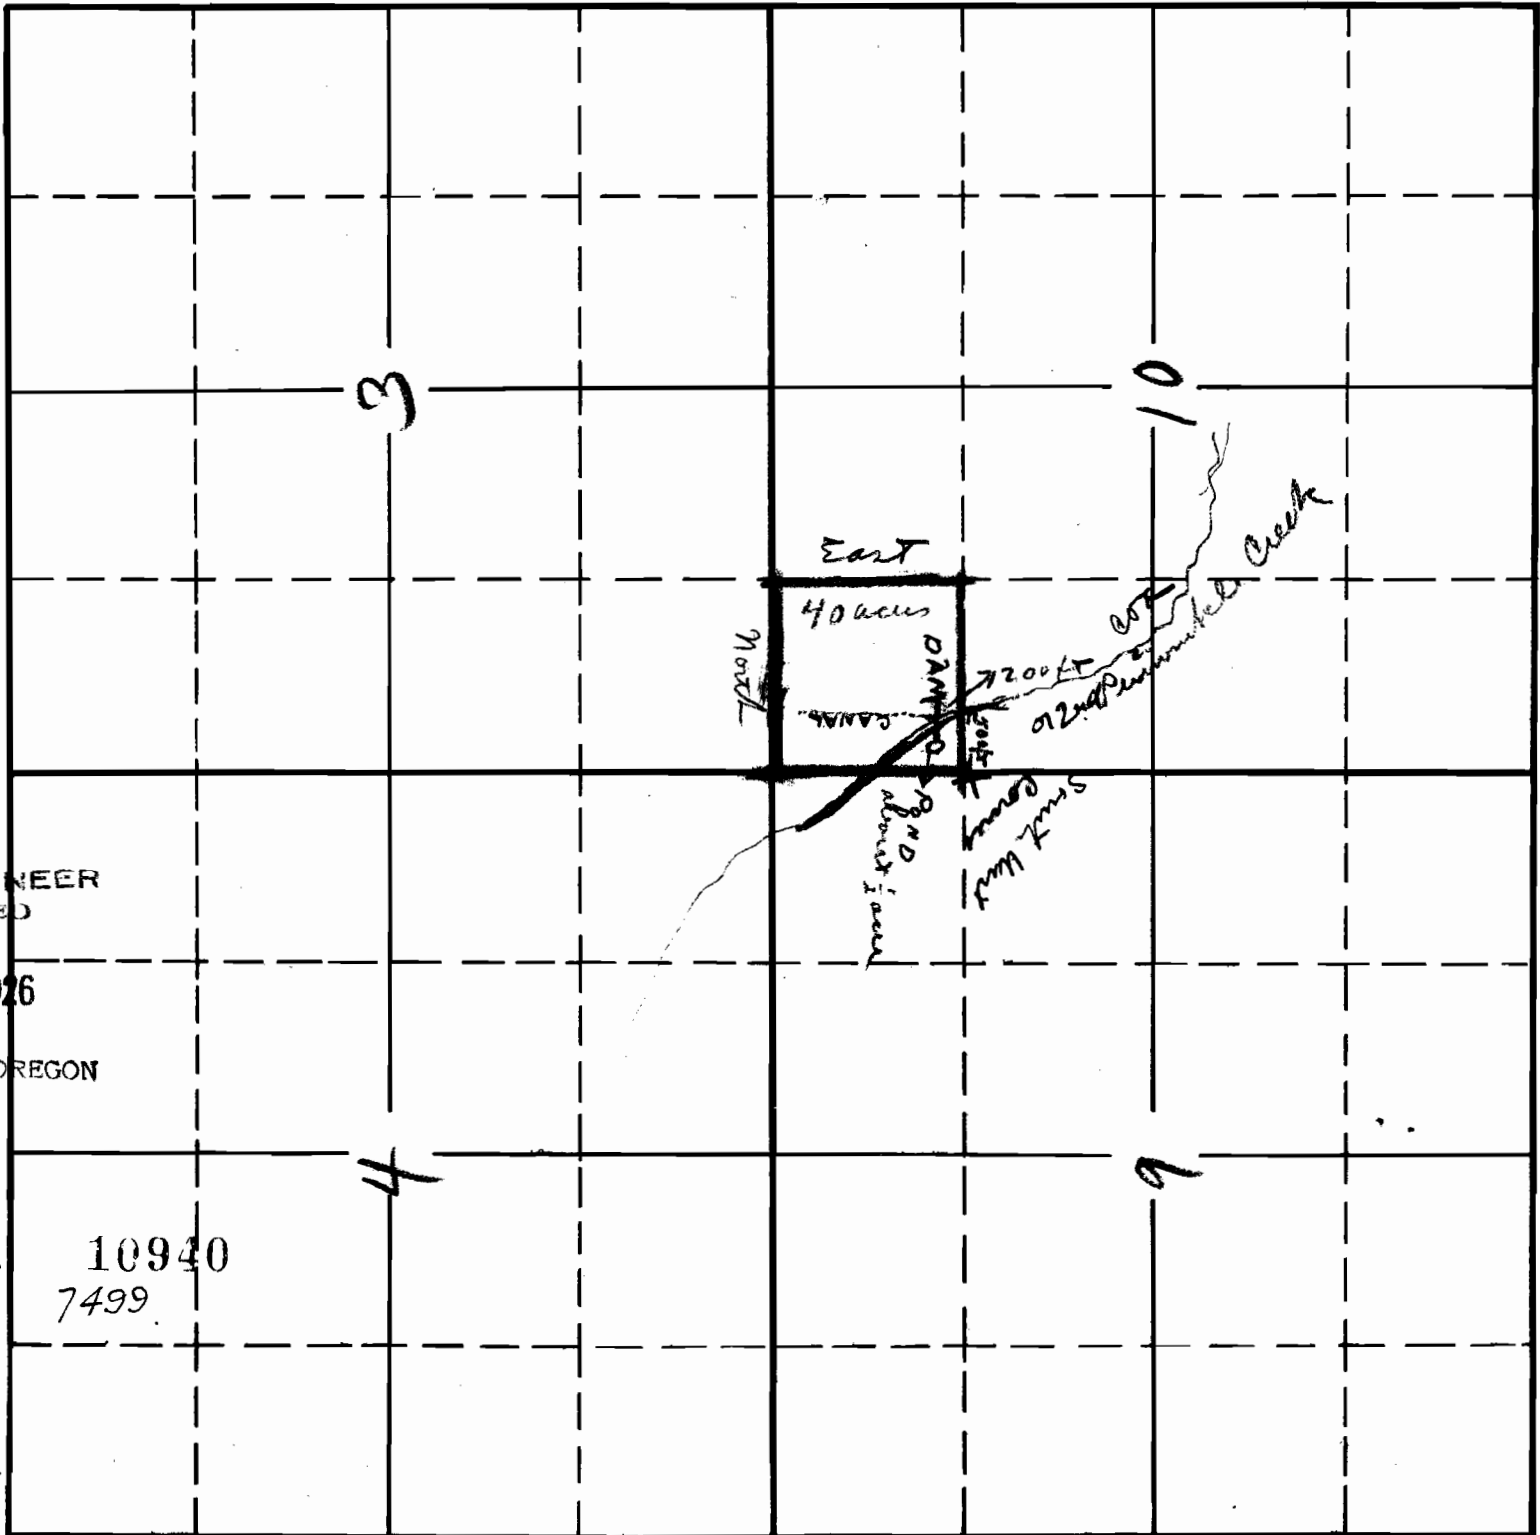

STATE ENGINEER
RECEIVED

JUL 28 1926

SALEM, OREGON

Application No. 10940
Permit No. 7499

