


Sec. 18
Tp. 8 S.
R. 1 E.
Sec. 13
Tp. 8 S.
R. 1 W.

STATE ENGINEER
RECEIVED

AUG 24 1926

SALEM, OREGON

Willamette Meridian

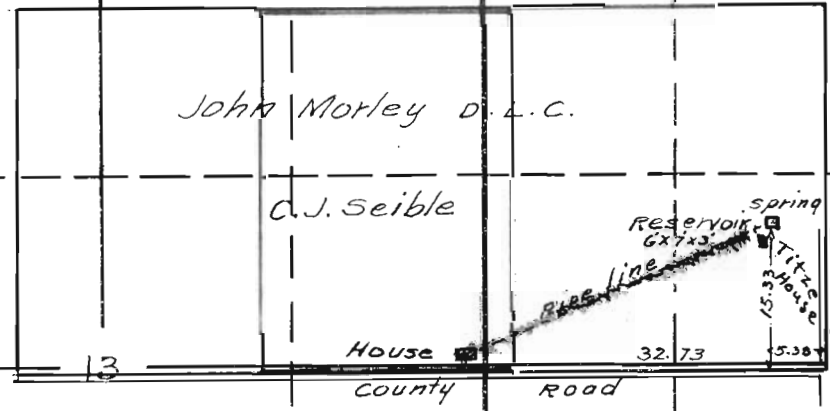

Application No.
Permit No.

11048
7518