


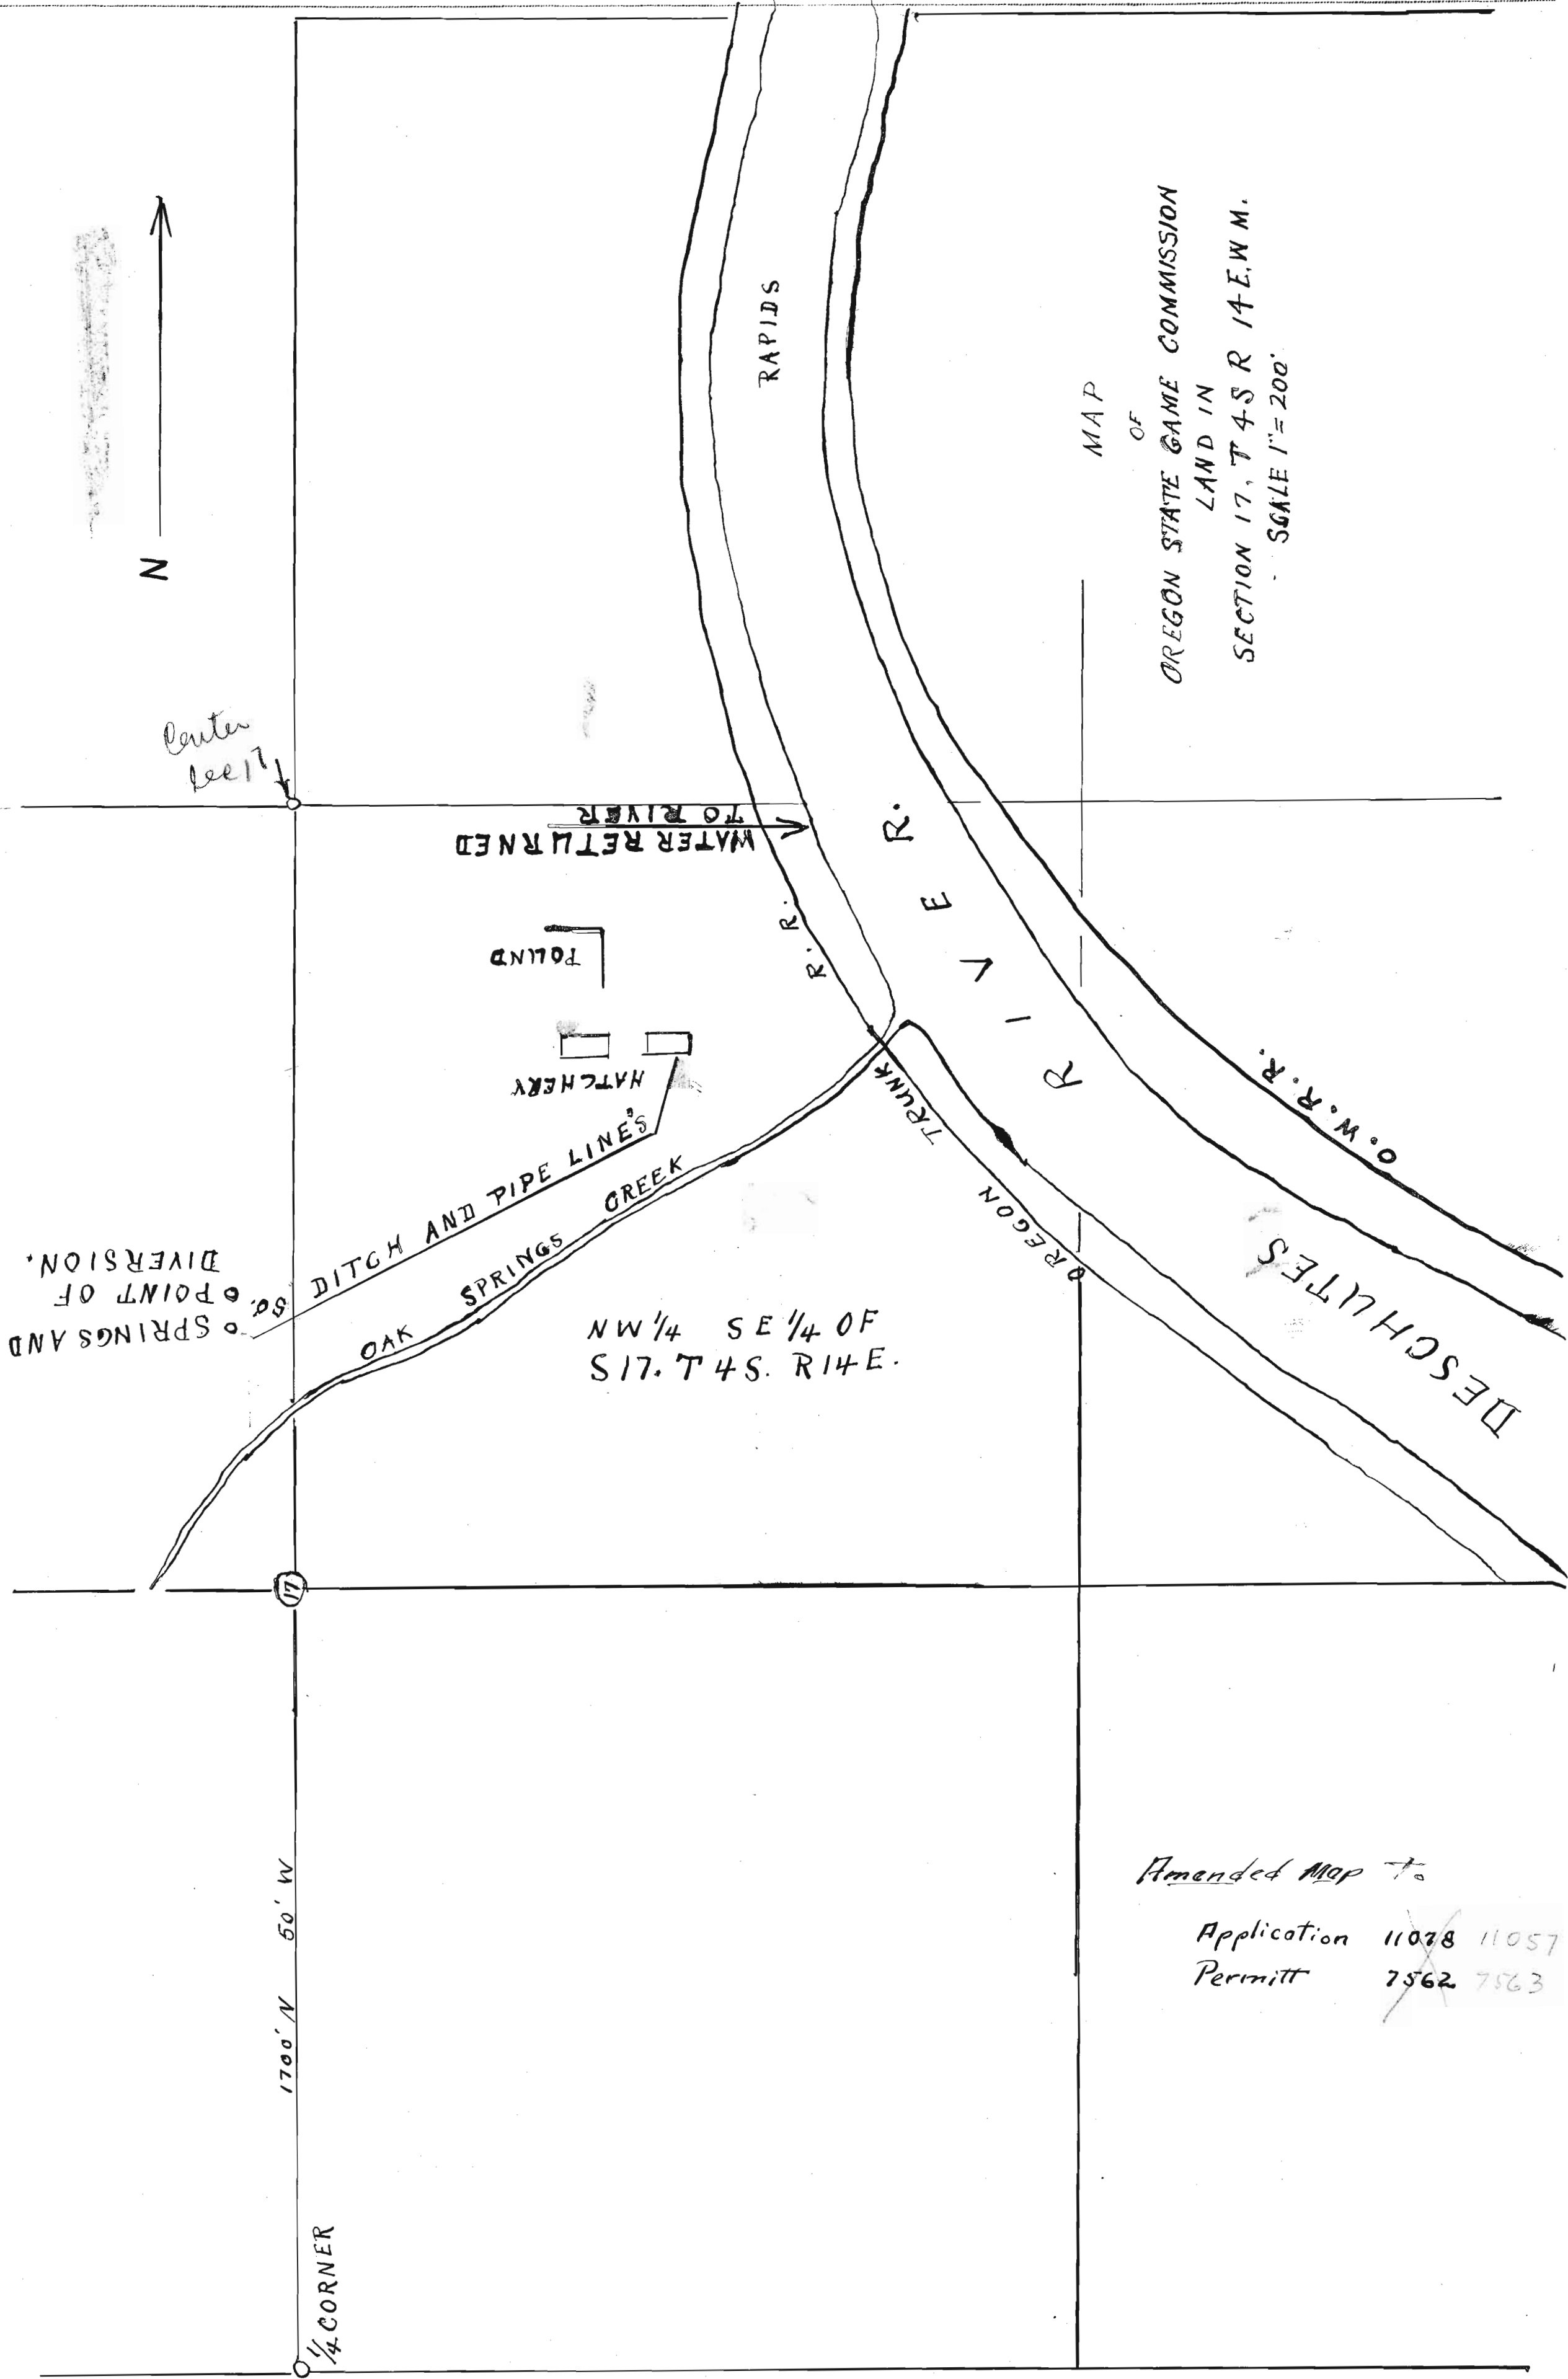


Amended Map to

Application	11078	11057
Permitt	7562	7563

11021

MAP
ACCOMPANYING APPLICATION
FOR PERMIT TO APPROPRIATE
WATER

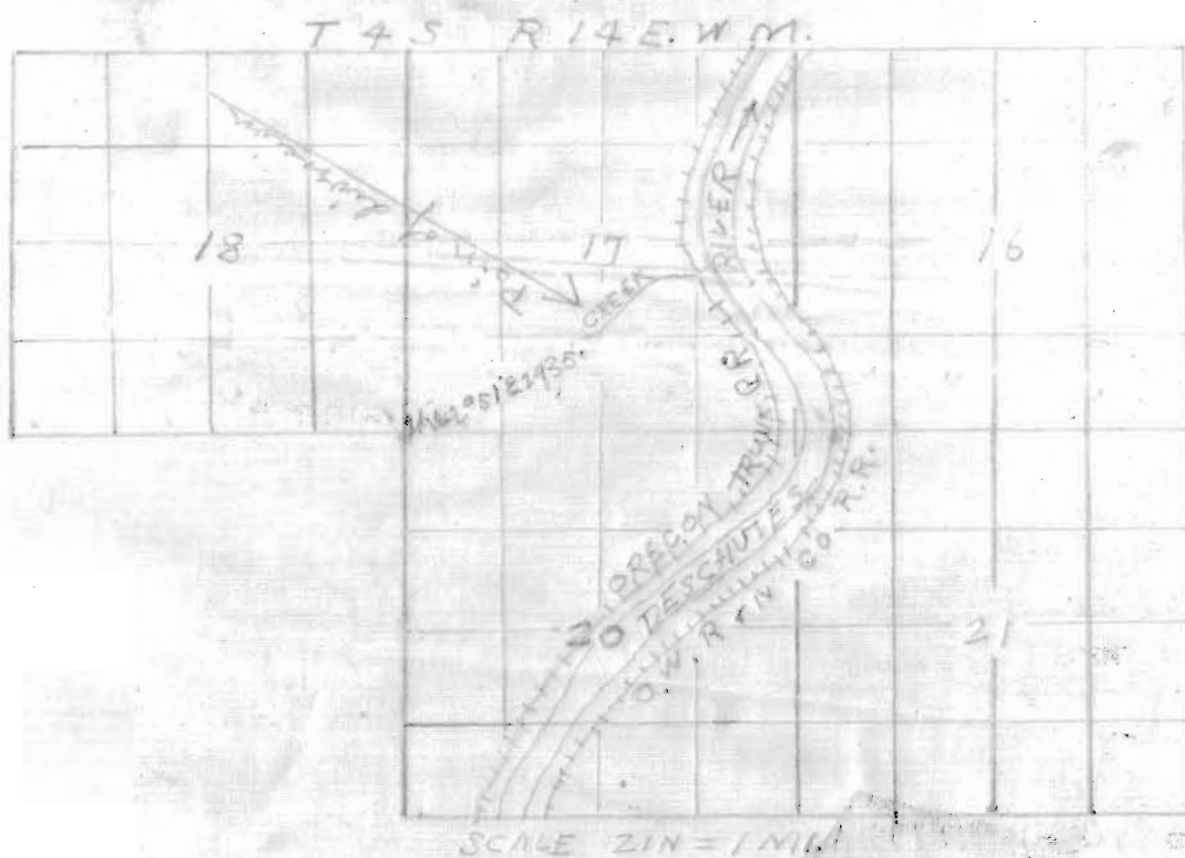

STATE ENGINEER
RECEIVED

AUG 27 1926

SALEM OREGON

W. O. Hadley
Supt. of Highways

Application No. 11057
Permit No. 7563

11021