


MAP

Accompanying Final Proof Application N^o 11100 Permit N^o 7584
of F.A. and O.M. Copple of Jacksonville Oregon, to the Waters
of Big Applegate River Jackson County Oregon, for Irrigation Purposes.

November 1927

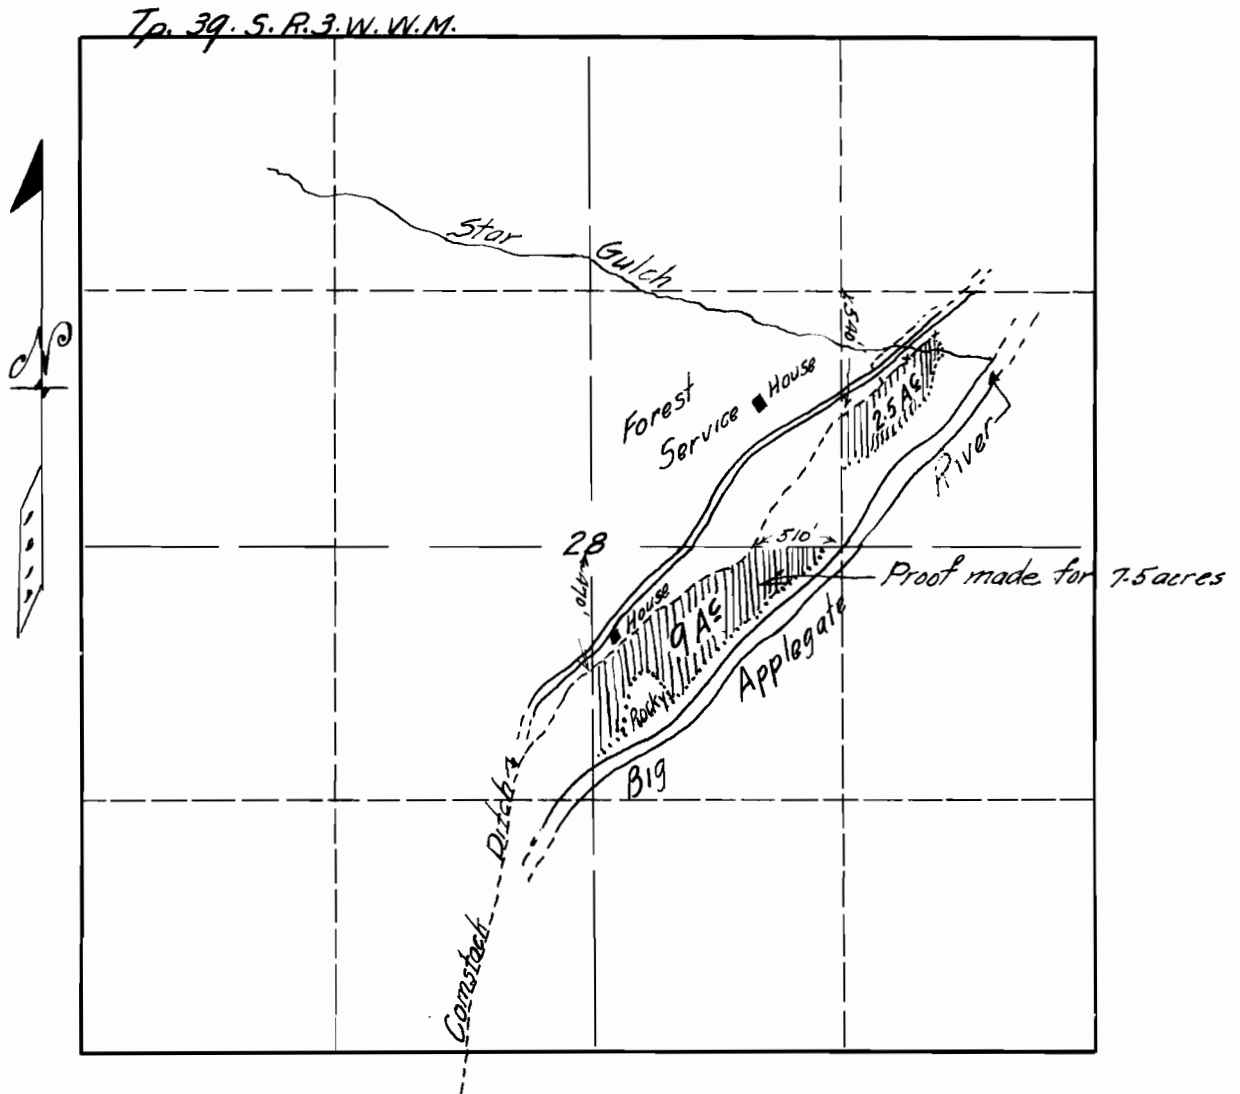

Map made from Actual Measurements taken in Field
by me, the same showing correctly location of Ditches, Lands
to be Irrigated, together with Streams and Ditches in
Immediate Vicinity.


Scale 1" = 100'

A. Everett Smith
Asst. Water Master Dist. #15

—MAP—

Accompanying application of F. A and O. M. COPPLE of Jacksonville Jackson County, Oregon. for permit to the waters of Big Applegate River, Jackson County, Oregon. for irrigation purposes.

—September 1926.—

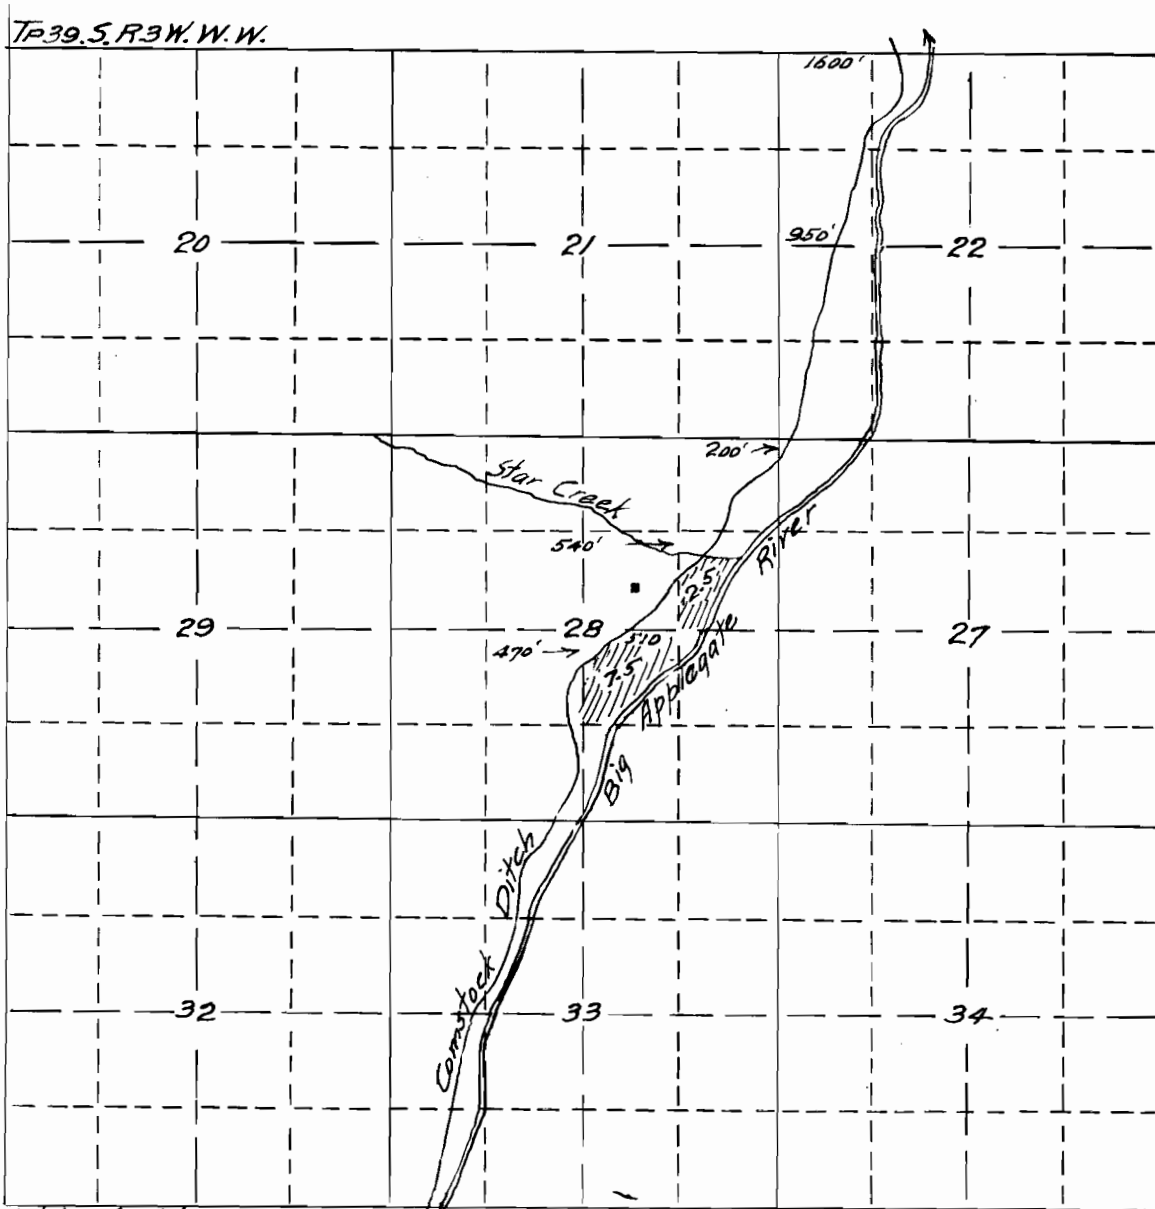

Map made from measurements taken in the field by Mr Copple the same showing correctly, location of ditch, lands to be irrigated, together with streams and ditches in immediate vicinity. Compiled by.

—Fred. N. Cummings. C.E.—

Appl. No. 11100
Per. No. 7584