


Tw'p 38S - R. 3E.

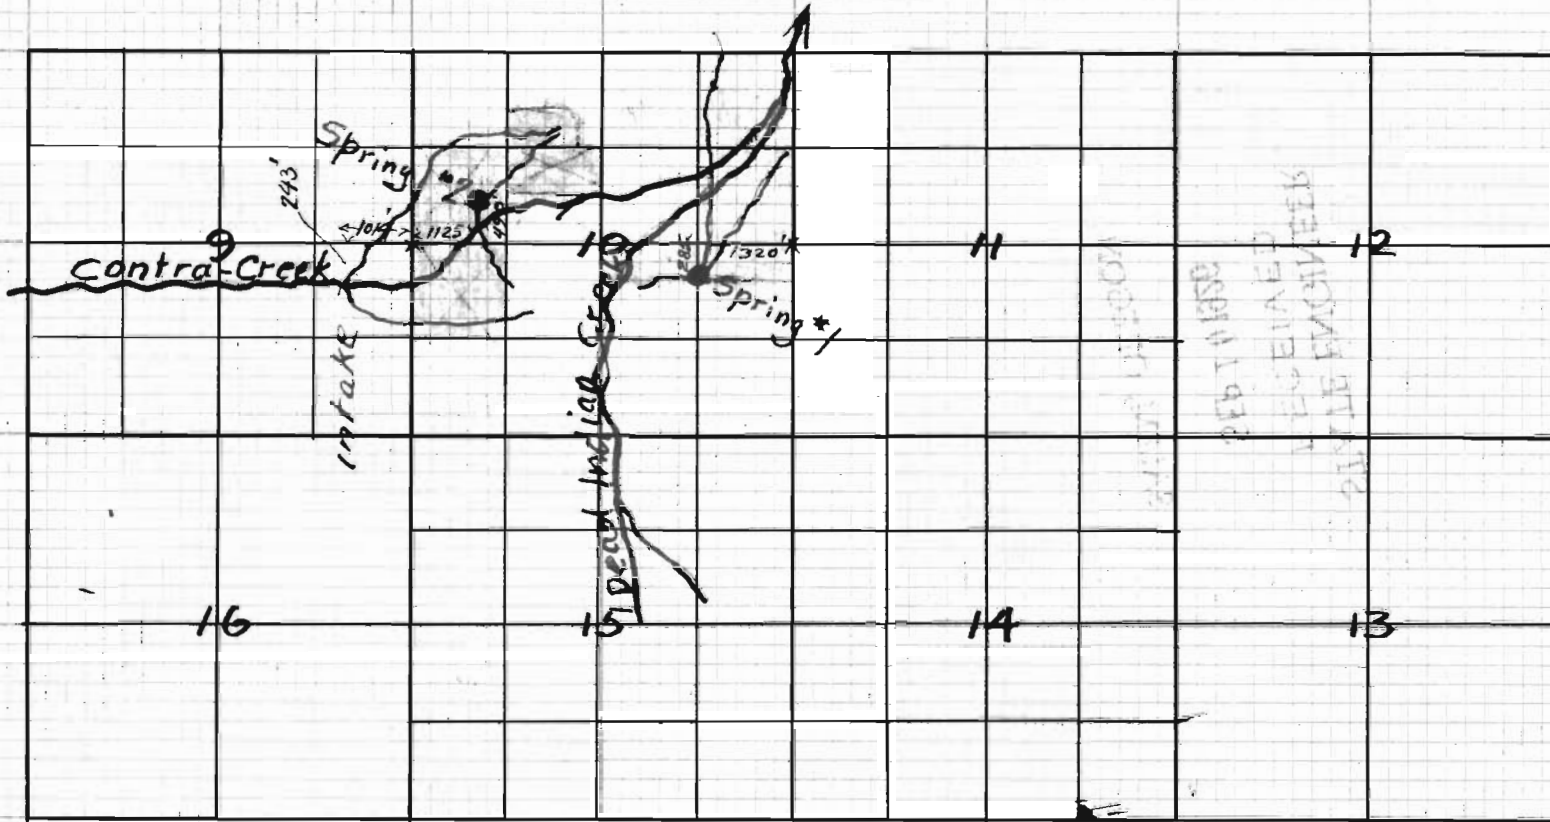

Appl. No. 11020
Per. No. 7586