


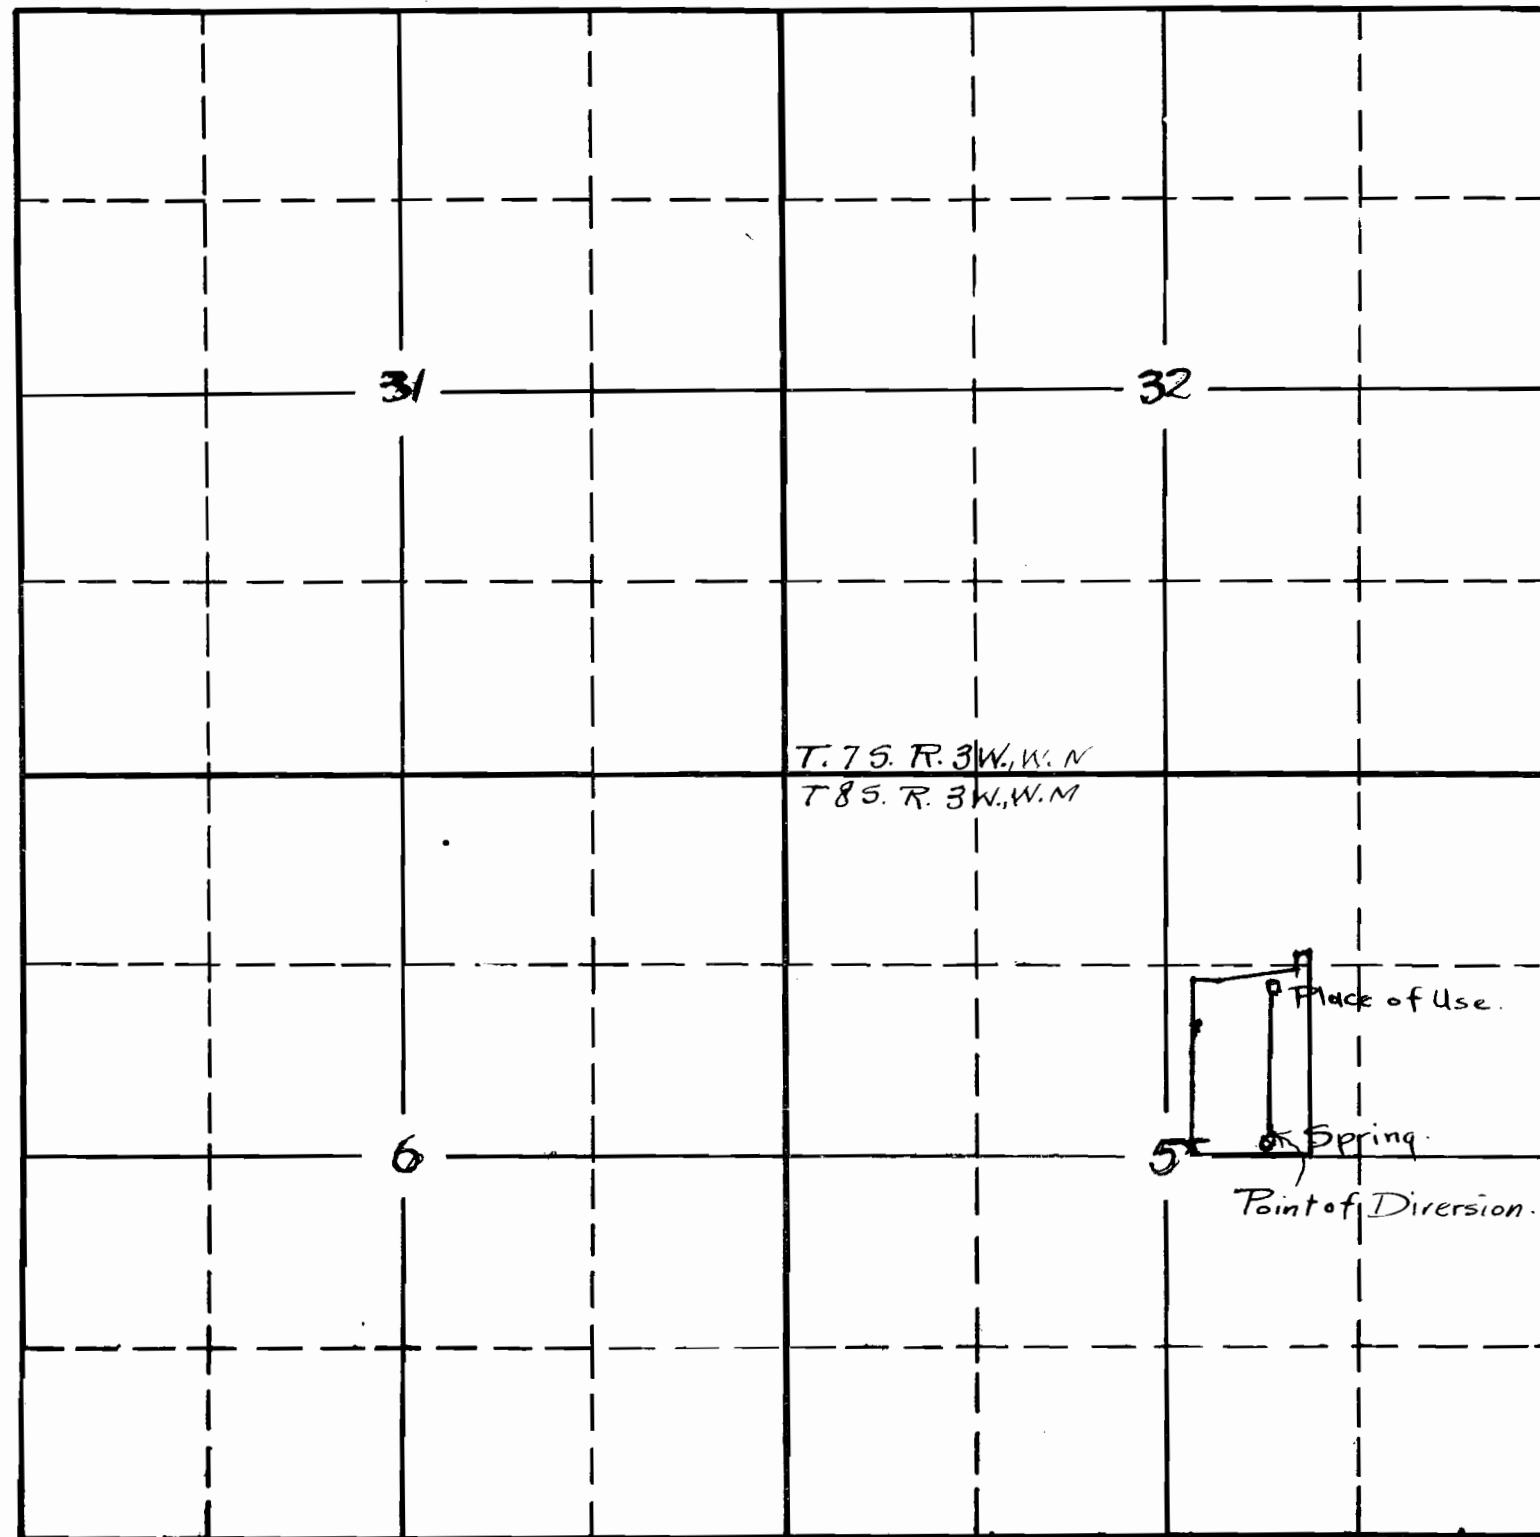

Sec. 5

Tp. 8 S

R. 3 W

Application No. 11190

Permit No. 7677