


Sec. 25

Tp. 7. S.

R. 4. W.

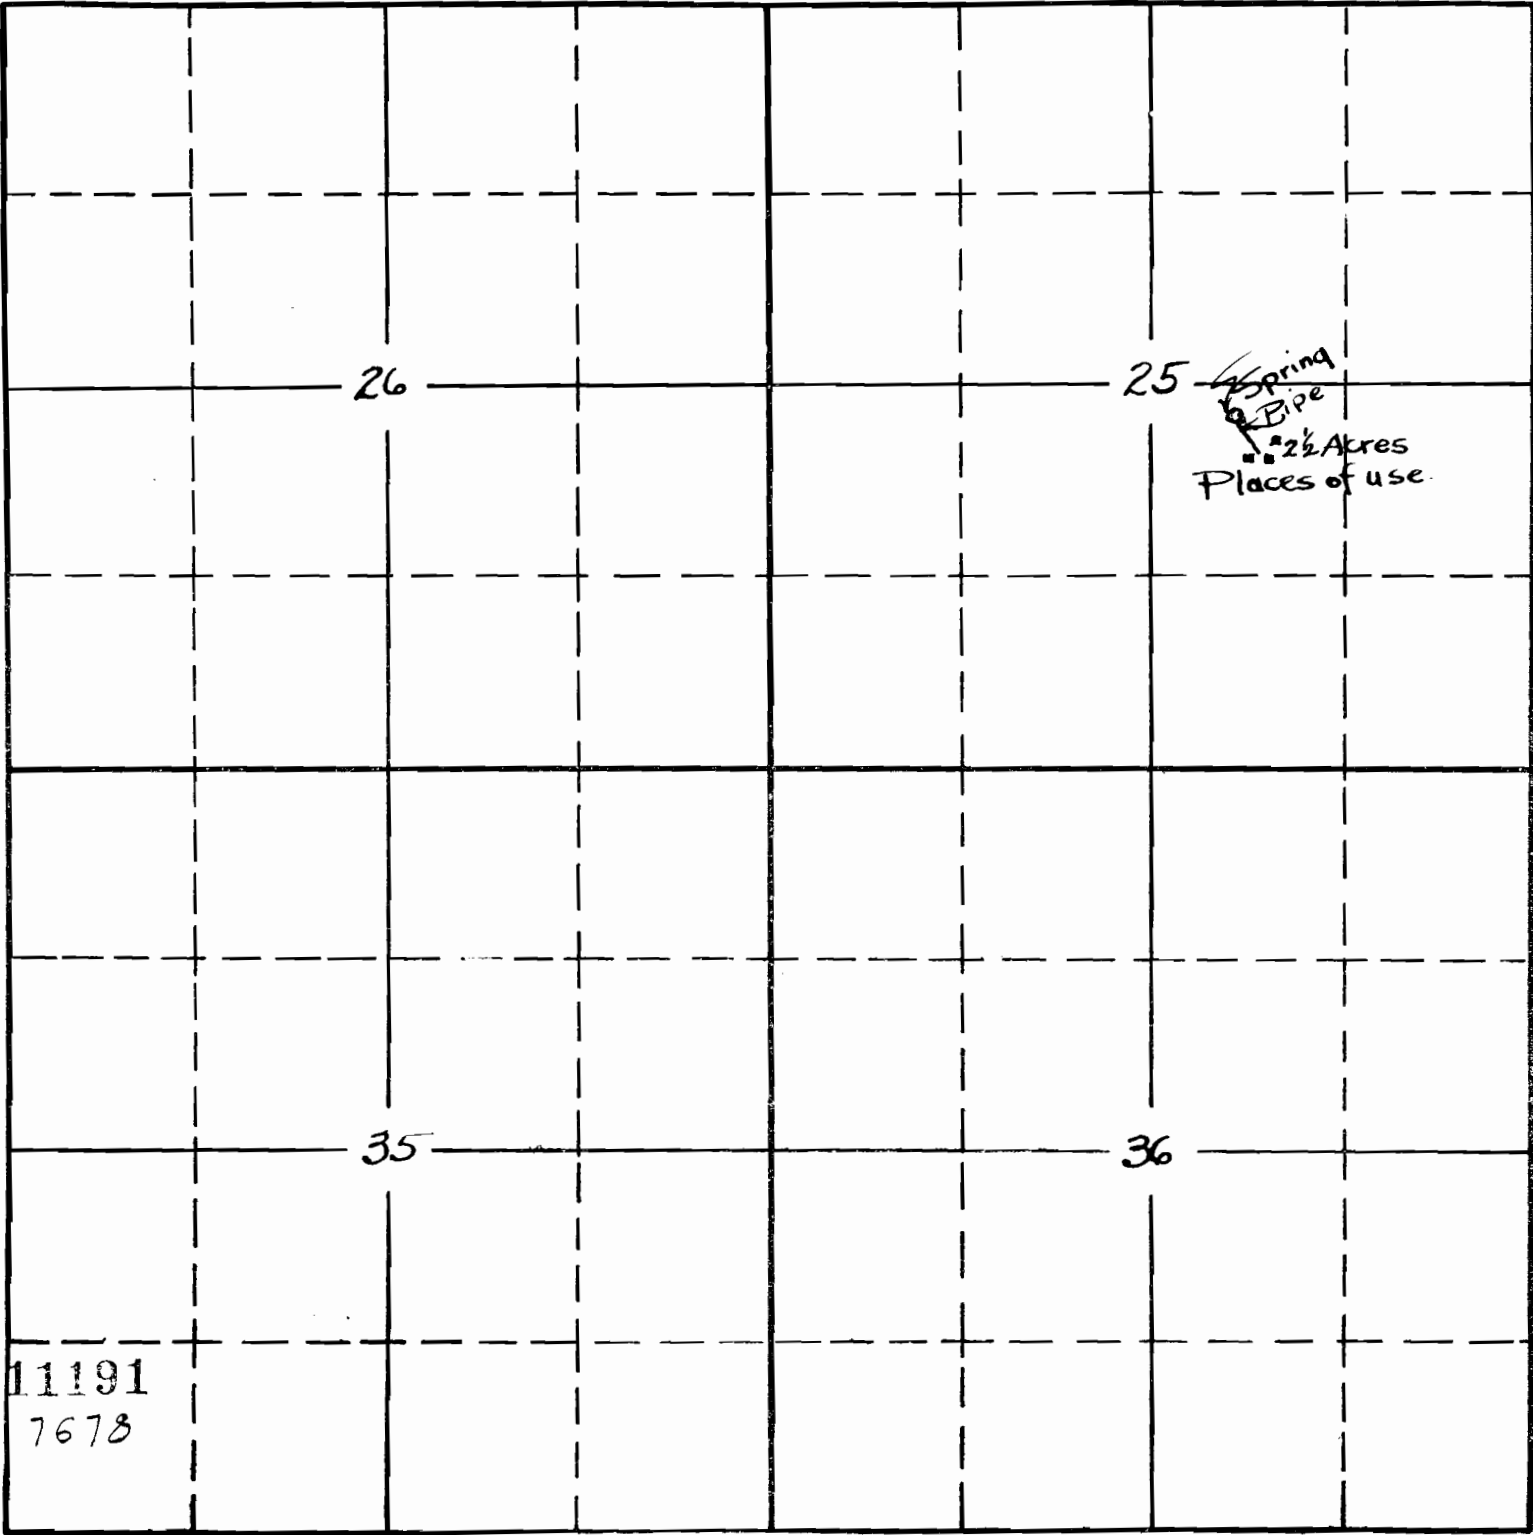

Application No.
Serial No.

11191
7678