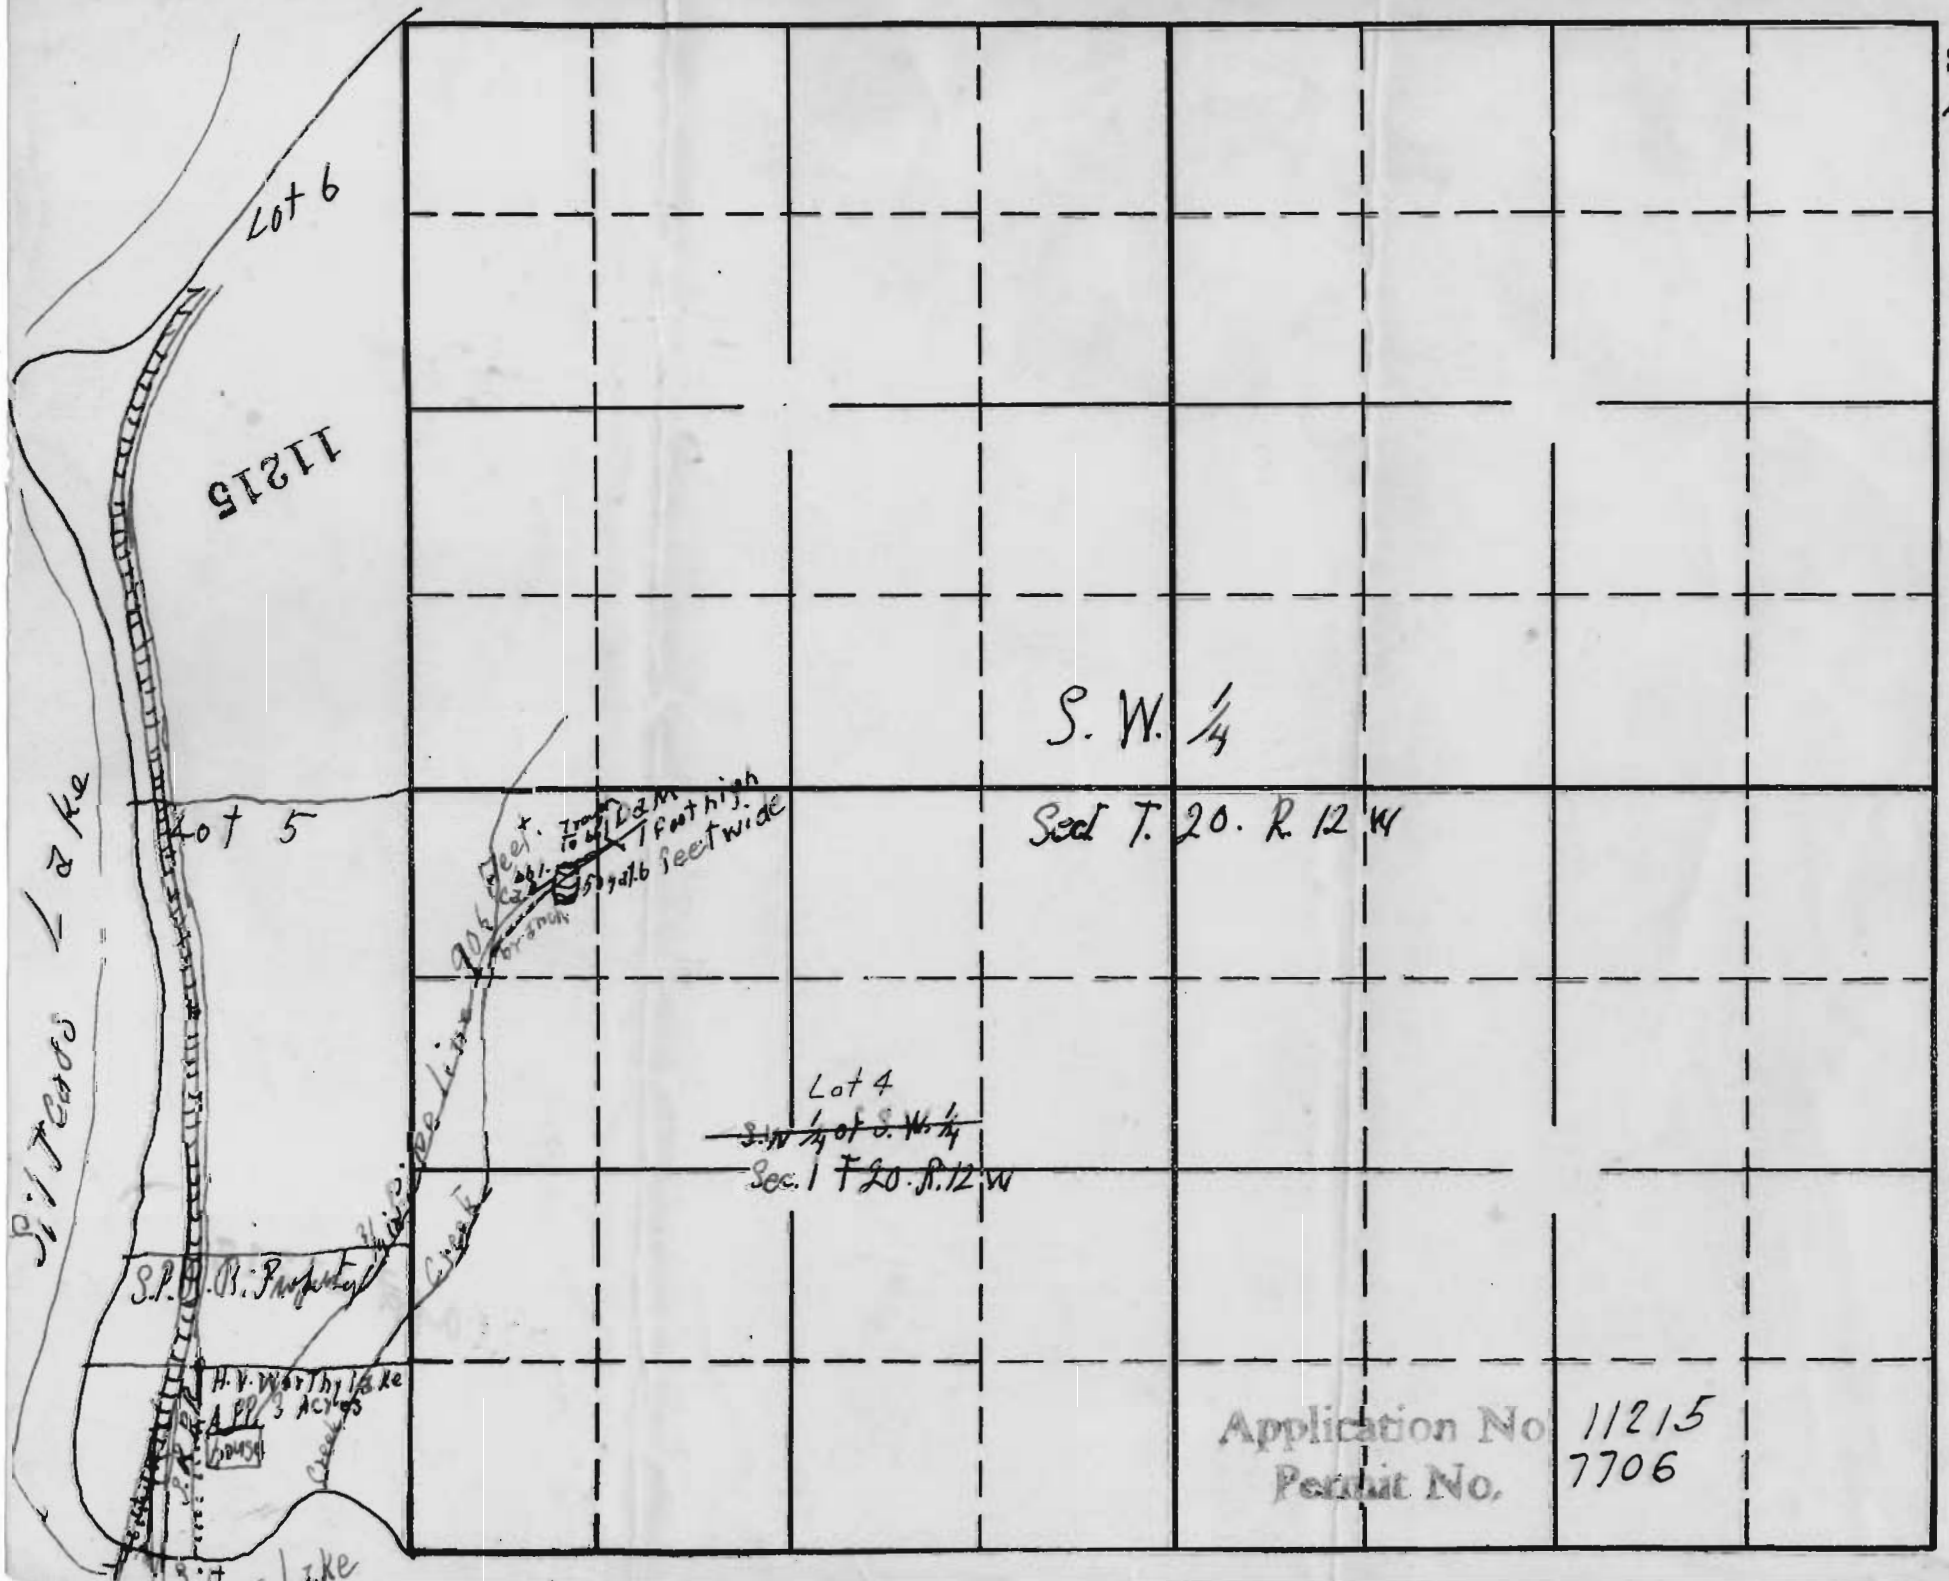
Sec. 1
Lot 5
Tp. 20
R. 12 W.
Lot 6
11215
Lot 5
S. W. 1/4
Sec 1 T. 20. R. 12 W
Lot 4
S.W. 1/4 of S.W. 1/4
Sec. 1 T 20. R. 12 W
Application No. 11215
Permit No. 7706