


SW N.W. corner
of the N.E. $\frac{1}{4}$ of
Sec. 20.

Map does not check
with Plat Book

20

108840

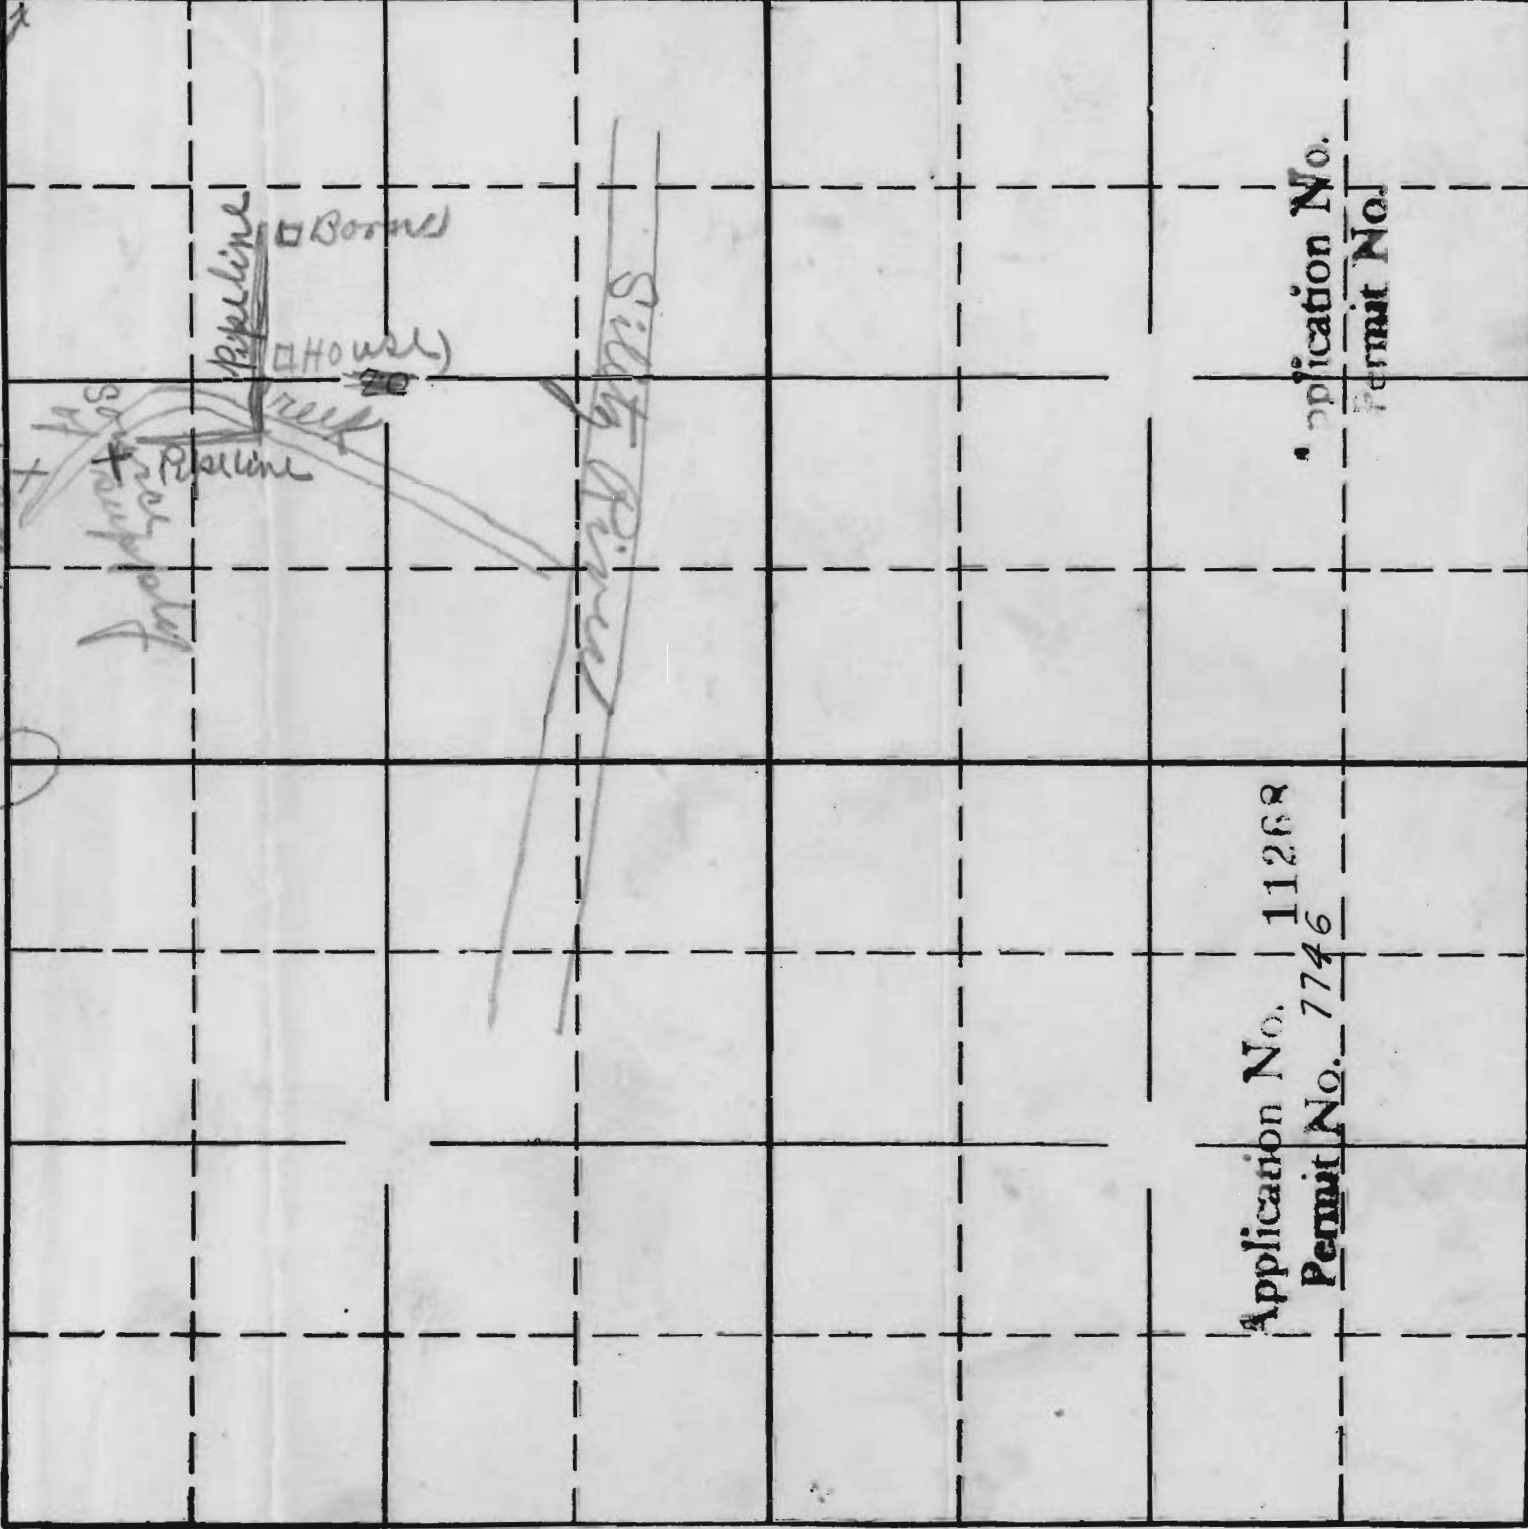

Application No. 11268
Permit No. 7746

Application No.
Permit No.

Sec. 20

Tp. 8

R. 10