


Township 6 South,

Range 13 East W.M.

Orrion Farlow

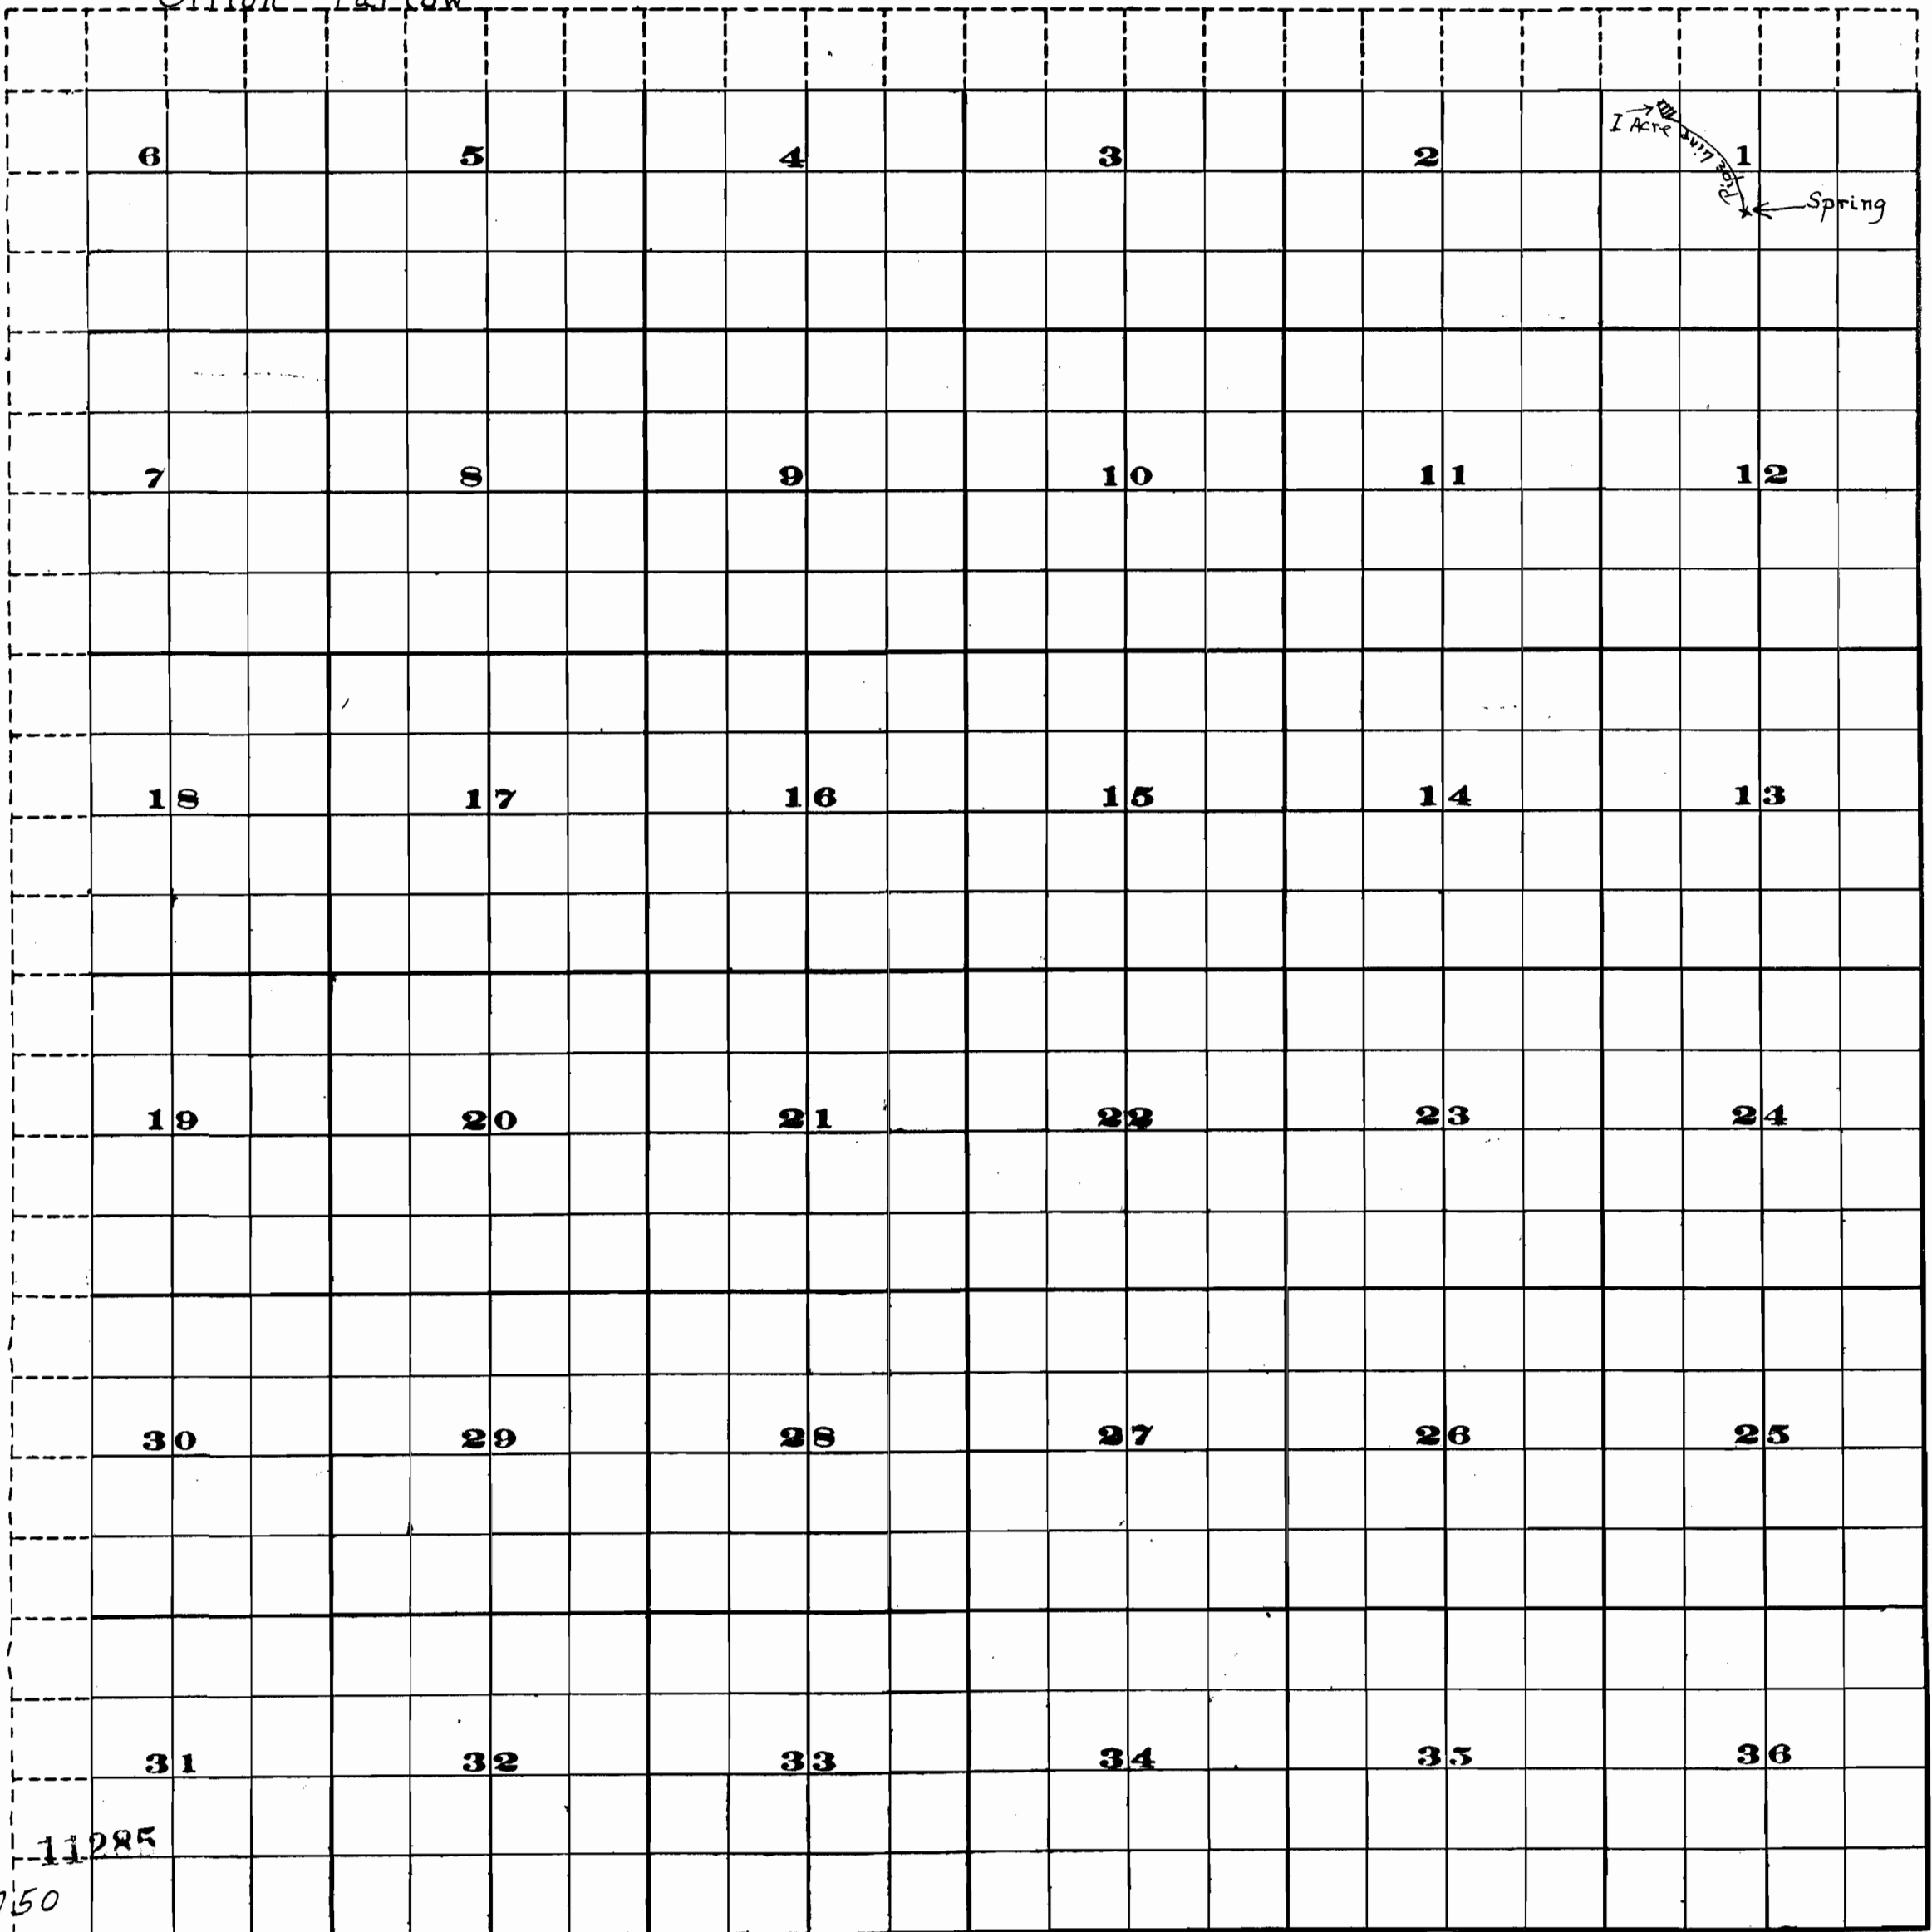

11285

Application No.
 Permit No. 7750



Scale of Feet.