



T.17S. R.21E. W.M.

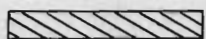

Permit No. 26390

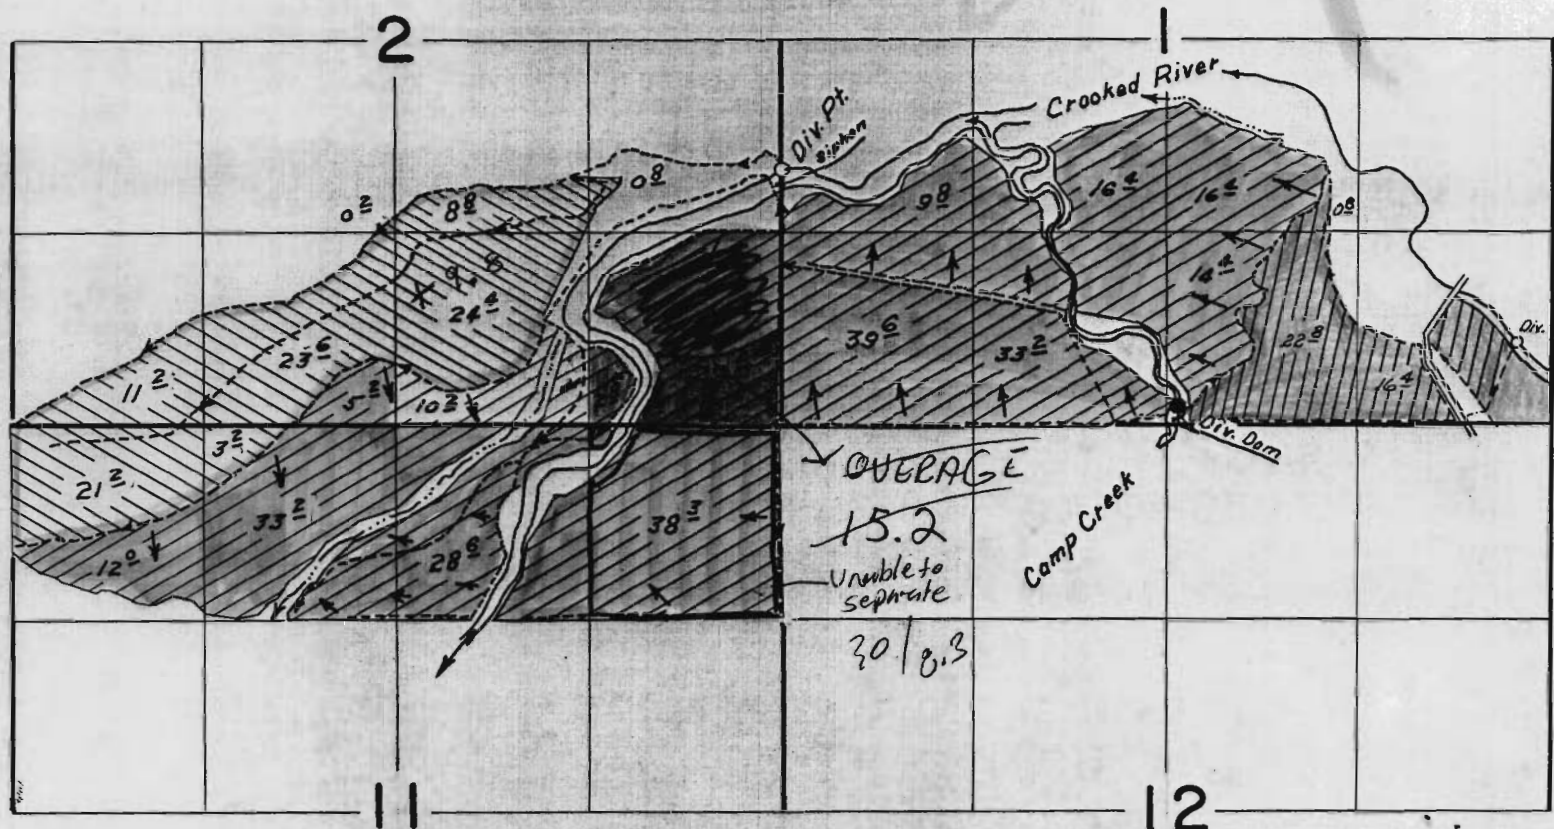

Permit No. 22142



Permit No. 35497

FINAL PROOF SURVEY

UNDER

Application Nos. 47742, 28130, 33409 35497, Permit Nos. 22142, 26390

IN NAME OF

GALE MERWIN

Aug. 4, 1977 D. NORBY
Surveyed Sept. 29, 30, 1964 By: R. Jackson