


Sec. 13

Tr. 5 S.

R. 3 W.

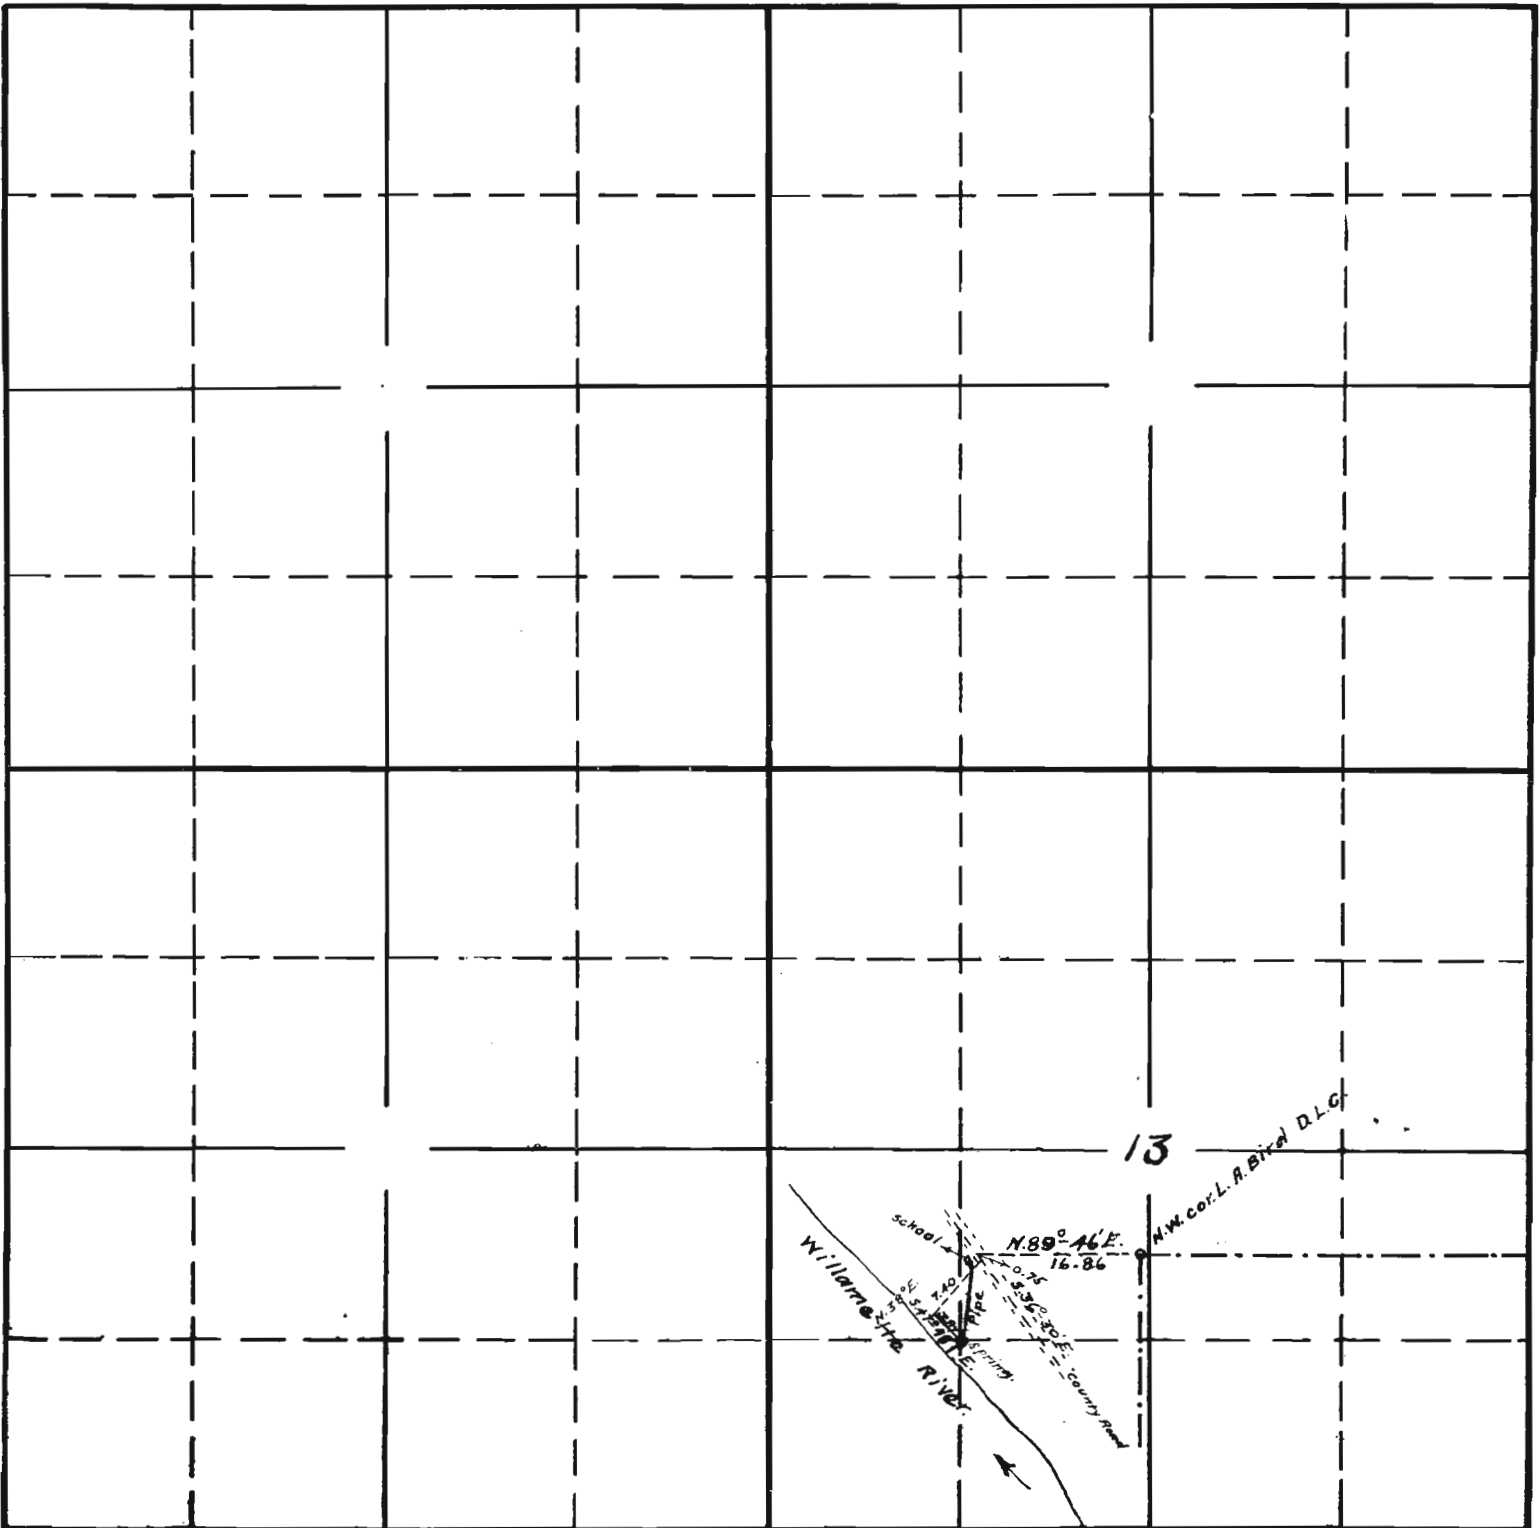

Appl. No. 10725  
Per. No. 7760