


H099

-MAP-

Accompanying application for permit
to appropriate water

Spring is located 740 ft. South and 300 ft. east of
¼ cor., between sec. 29 and 30. T7S. R3W. W.M.

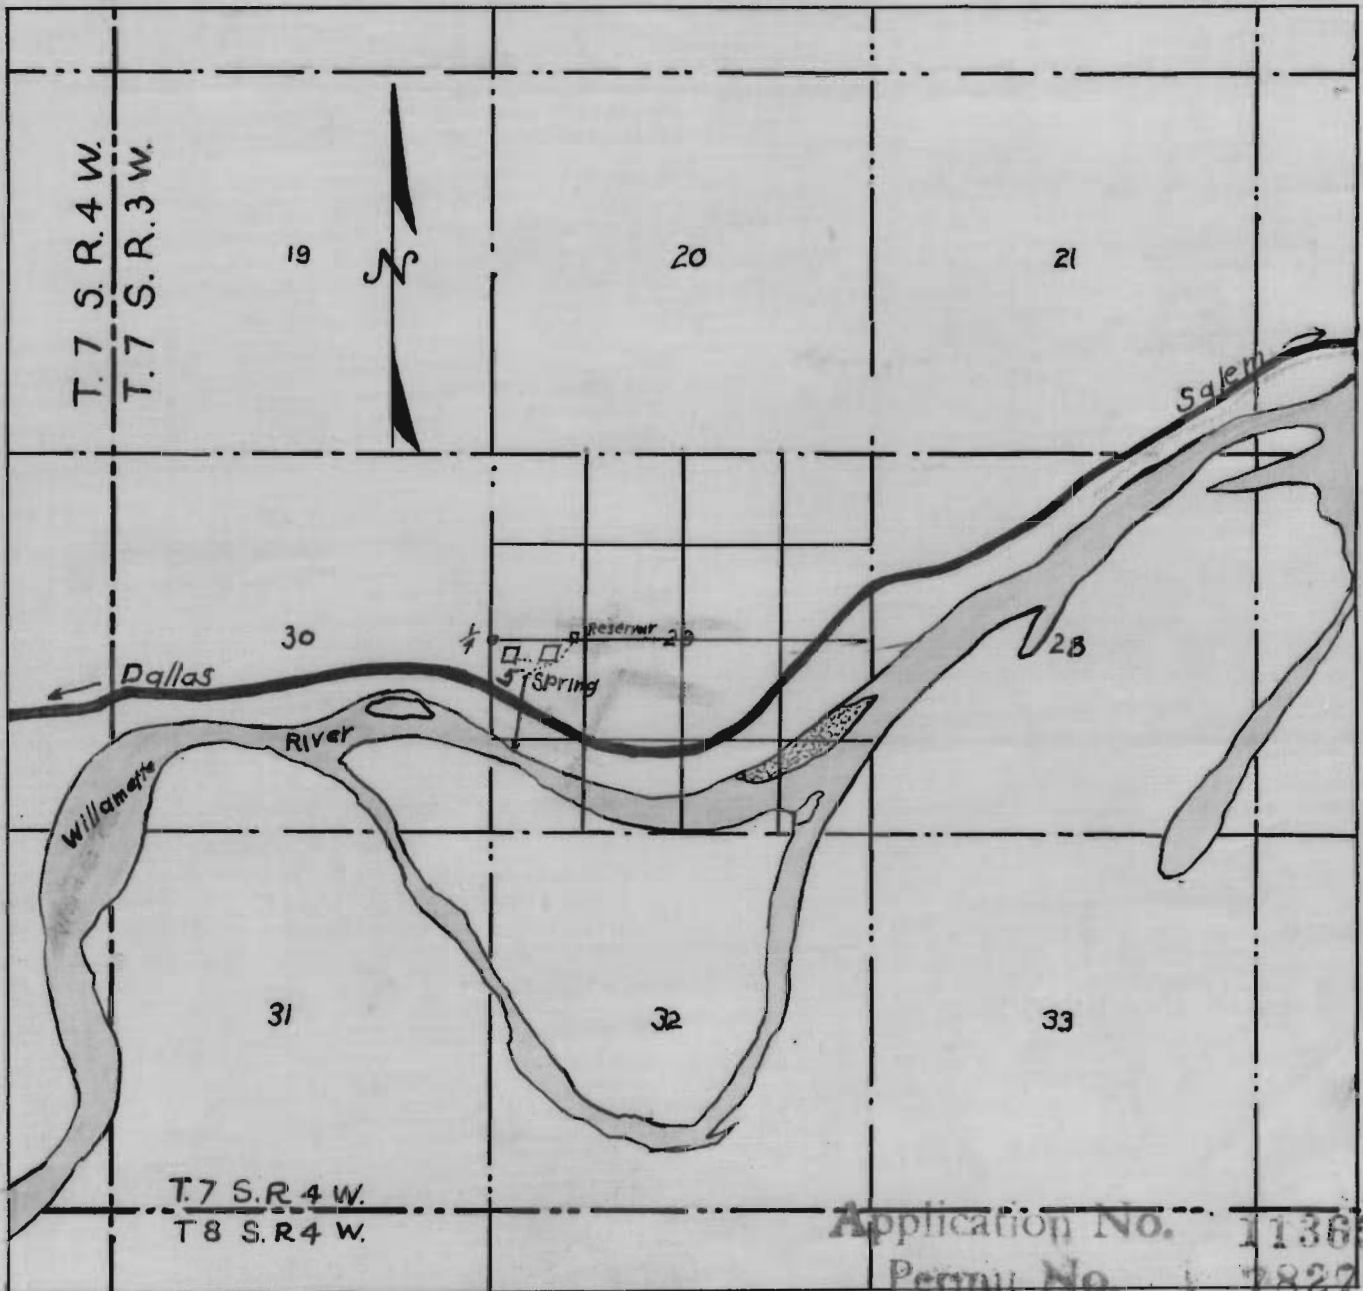

Application No. 11365
Permit No. 7827

1365