


Application No. 11362

Permit No. 7834

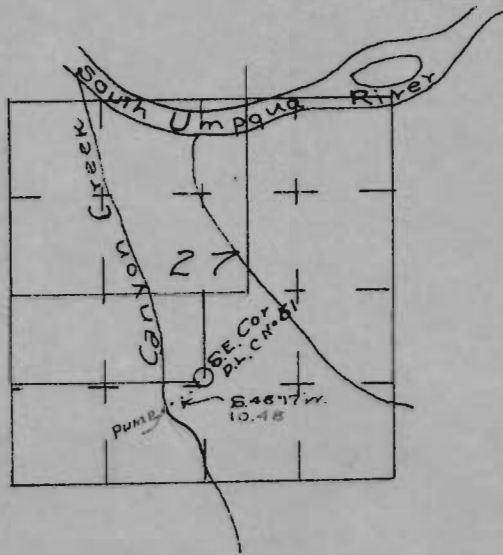

*A.M. SHAFFER PUMP*

*SEC. 27*

*TP. 30S. R 5W.*

*Douglas County, Oregon.*

*Scale 40 Chs. to 1 inch.*