


Sec. 18

Tp. 8 S.

R. 2 W.

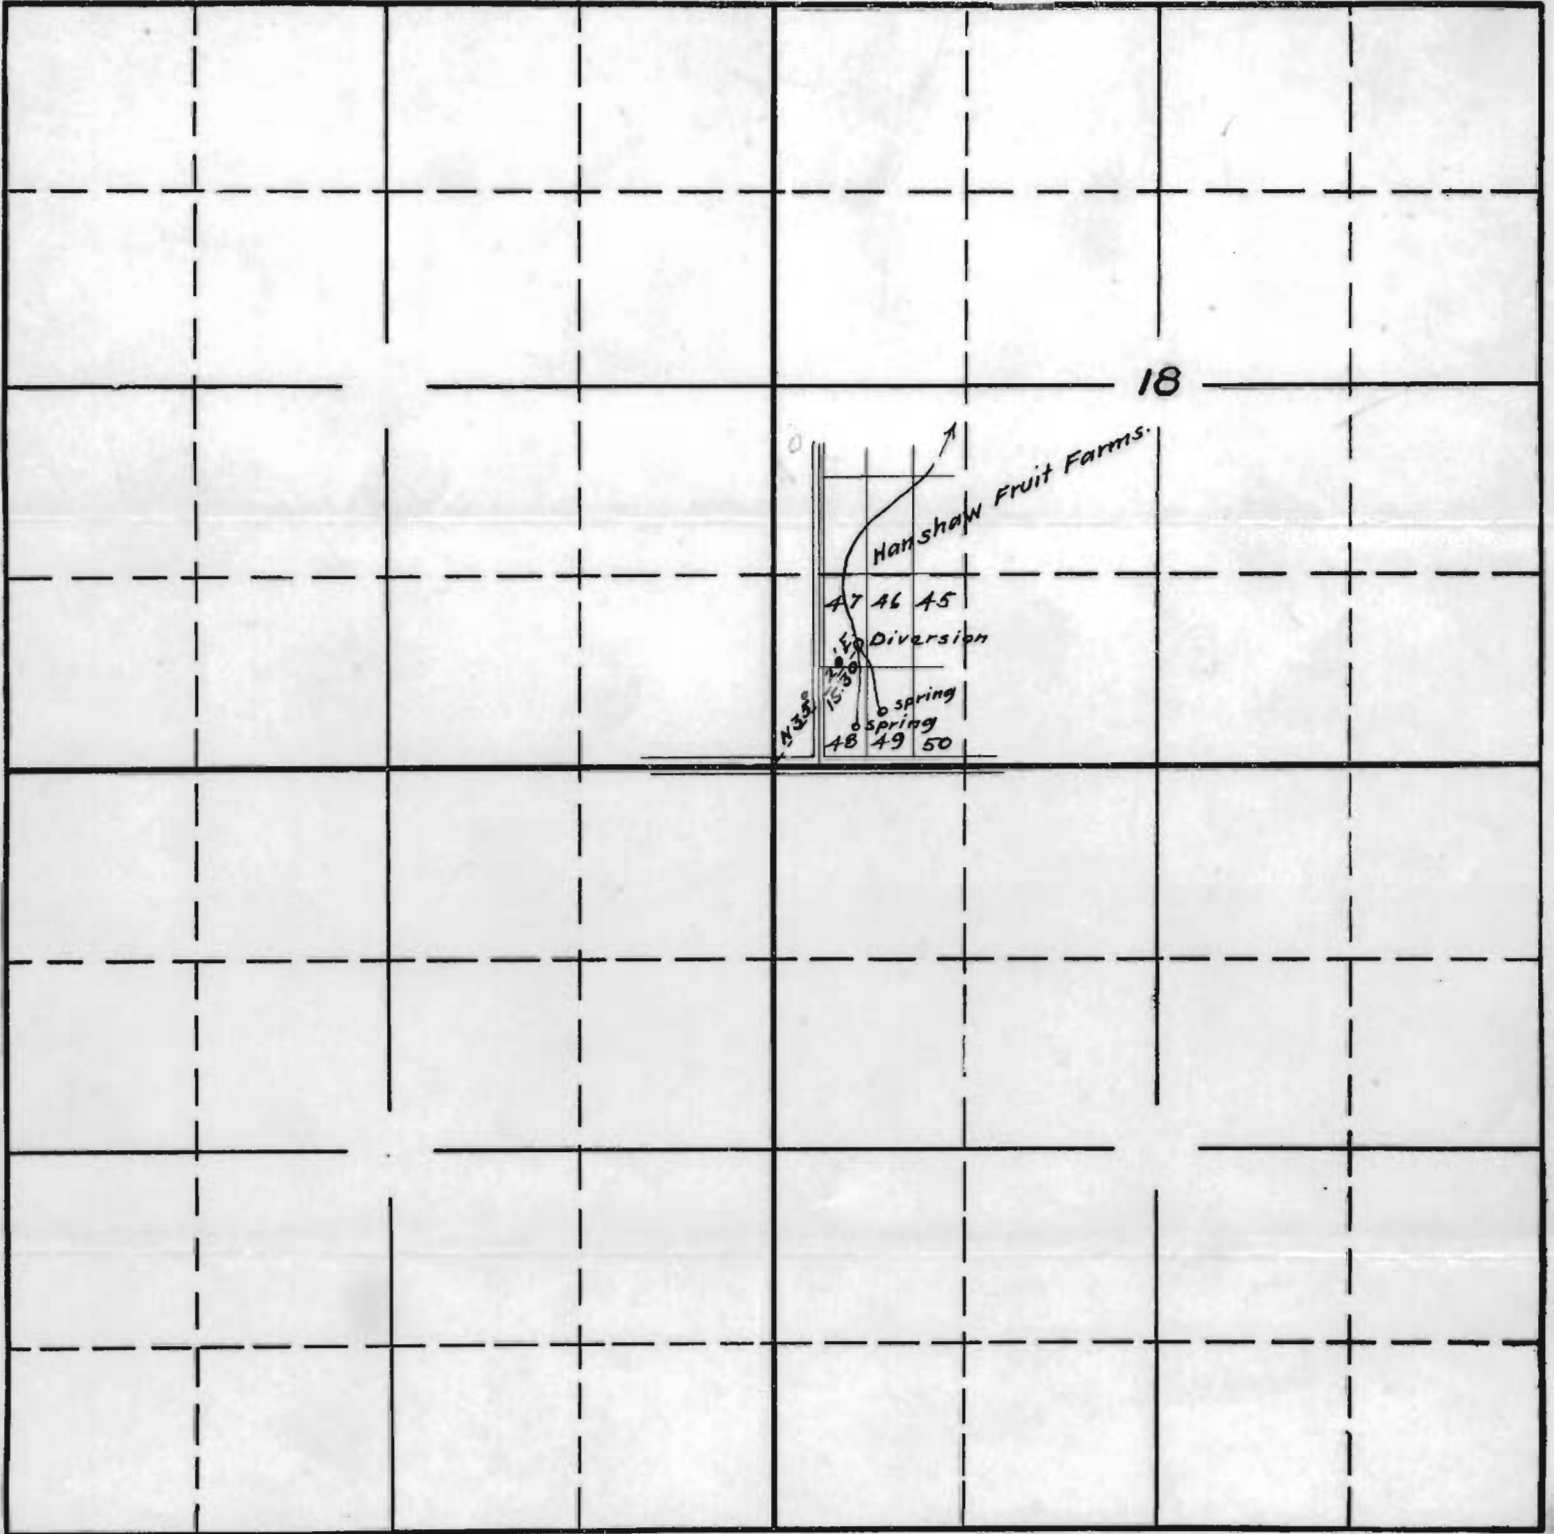

Application No. 11409  
Permit No. 7887